

CARD MUST BE TYPED

State of Kansas

CARD MUST BE SIGNED

NOTICE OF INTENTION TO DRILL

(see rules on reverse side)

Starting Date 1 29 1986
month day yearAPI Number 15-077-21,128-0000
_____ EastOPERATOR: License # 6581
Name Bison Energy Corporation
Address 16 W. 4th, Suite B
City/State/Zip Hutchinson, KS 67501
Contact Person C. J. Lett III
Phone (316) 663-2262C..N/2..NW..SE Sec.8... Twp.31.. S, Rg..8..... X West
..... 2310..... Ft. from South Line of Section
..... 1980..... Ft. from East Line of Section

(Note: Locate well on Section Plat on reverse side)

CONTRACTOR: License # 6333
Name DaMac Drilling Inc.
City/State Box 1164, Great Bend, KS 67530Nearest lease or unit boundary line 330..... feet
County HarperLease Name... Fleming..... Well # 1B-8.....
Ground surface elevation feet MSLWell Drilled For: Well Class: Type Equipment:
 Oil SWD Infill Mud Rotary
 Gas Inj Pool Ext. Air Rotary
 OWWO Expl Wildcat CableDomestic well within 330 feet: _____ yes no
Municipal well within one mile: _____ yes no

If OWWO: old well info as follows:

Depth to bottom of fresh water 200.....
Depth to bottom of usable water 200.....Surface pipe by Alternate: 1 X 2 1/2
Surface pipe planned to be set 250.....Conductor pipe required East
Projected Total Depth 4500 feet

I certify that well will comply with K.S.A. 55-101, et seq., plus eventually plugging hole to KCC specifications.

Date 1/28/86 Signature of Operator or Agent *Meres Cholar* Title as agent

For KCC Use:


Conductor Pipe Required feet; Minimum Surface Pipe Required 200 feet per Alt.
This Authorization Expires 7-28-86 Approved By 1-28-86 *RCH/KCH*

Must be filed with the K.C.C. five (5) days prior to commencing well
This card void if drilling not started within six (6) months of date received by K.C.C.

Important procedures to follow:

1. Notify District office before setting surface casing.
2. Set surface casing by circulating cement to the top.
3. File completion forms ACO-1 with K.C.C. within 90 days of well completion, following instructions on ACO-1, side 1, and including copies of wireline logs.
4. Notify District office 48 hours prior to old well workover or re-entry.
5. Prior to filing Intent, prepare a proposed plugging plan in case well is D & A, then obtain approval of plan when calling district office prior to setting surface pipe.
6. Submit plugging report (CP-4) to K.C.C. after plugging is completed.
7. Obtain an approved injection docket number before disposing of salt water.
8. Notify K.C.C. within 10 days when injection commences or terminates.
9. If an alternate 2 completion, cement in the production pipe from below any usable water to surface within 120 days of spud date.

A Regular Section of Land
1 Mile = 5,280 Ft.

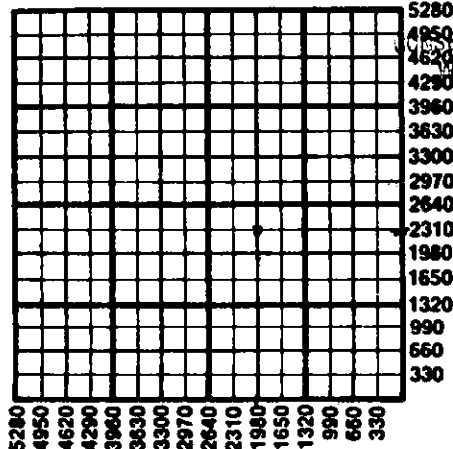

RECEIVED

STATE CORPORATION COMMISSION

JAN 28 1986

1-28-86

CONSERVATION DIVISION

Wichita, Kansas

State Corporation Commission of Kansas
Conservation Division
200 Colorado Derby Building
Wichita, Kansas 67202
(316) 263-3238