

STATE OF KANSAS  
STATE CORPORATION COMMISSION

WELL PLUGGING RECORD

15-101-20407-0000

Give All Information Completely  
Make Required Affidavit  
Mail or Deliver Report to  
Conservation Division  
State Corporation Comm.  
245 North Water  
Wichita, KS 67202

Lane \_\_\_\_\_ County, Sec. 13 Twp. 19S Rge. 29 ~~XE/W~~  
Location as "NE/CNW/SW" or footage from lines \_\_\_\_\_  
C W/2 SW

Lease Owner Beren Corporation  
Lease Name Voshell #2 Well No. \_\_\_\_\_

Office Address 970 Fourth Financial Cen. Wichita, Ks. 67202  
Character of Well (Completed as Oil, Gas or Dry Hole) \_\_\_\_\_

Dry Hole


Date Well completed October 19, 1979  
Application for plugging filed October 19 1979  
Application for plugging approved October 19 1979  
Plugging commenced October 19, 10:00 A.M. 1979  
Plugging completed October 19, 11:30 A.M. 1979

Reason for abandonment of well or producing formation \_\_\_\_\_  
No Commercial Production

If a producing well is abandoned, date of last production \_\_\_\_\_ 19\_\_

Was permission obtained from the Conservation Division or its agents before plugging was commenced? yes

Name of Conservation Agent who supervised plugging of this well Gilbert Balthazor  
Producing formation \_\_\_\_\_ Depth to top \_\_\_\_\_ Bottom \_\_\_\_\_ Total Depth of Well \_\_\_\_\_  
Show depth and thickness of all water, oil and gas formations.

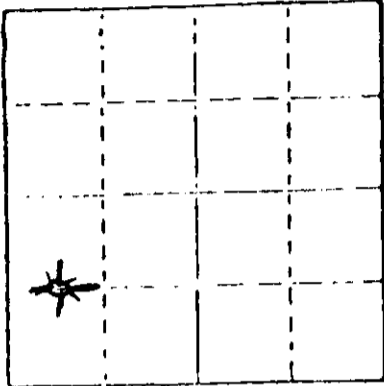

Locate well correctly on above Section Plat

OIL, GAS OR WATER RECORDS

CASING RECORD

LOCATION	CONTENT	FROM	TO	SIZE	PUT IN	PULLED OUT
Surface Casing	60-40 poz	0	300.22	8 5/8"	300.22	0

Describe in detail the manner in which the well was plugged, indicating where the mud fluid was placed and the method or methods used in introducing it into the hold. If cement or other plugs were used, state the character of same and depth placed, from \_\_\_\_\_ feet to \_\_\_\_\_ feet for each plug set.

- Plug #1 @ 750' with 70 sxs
- Plug #2 @ 280' with 20 sxs
- Plug #3 @ 40' with 15 sxs Hulls & 10 sxs  
5 sxs in Rat Hole  
50-50 poz 6% gel

STATE RECEIVED  
OCT 26 1979  
CONSERVATION DIVISION  
Wichita, Kansas

(If additional description is necessary, use BACK of this sheet)

Name of Plugging Contractor Pioneer Drilling Company, Inc.  
308 West Mill Plainville, Kansas 67663

STATE OF Kansas COUNTY OF Sedgwick, ss.  
(employee of owner) or (owner or operator)  
of the above-described well, being first duly sworn on oath, says: That I have knowledge of the facts, statements, and matters herein contained and the log of the above-described well as filed and that the same are true and correct. So help me God.

(Signature) Max S. Hauer

(Address)

SUBSCRIBED AND SWORN TO before me this 25th day of Oct, 19 79

" Karen G. Berry  
Notary Public.

My commission expires Nov 4, 1980



W E L L L O G

OPERATOR: Beren Corporation 15-10-20407-0000

WELL NAME: Voshell #2 LOCATION: C W/2 SW 13-19S-29W

COUNTY: Lane STATE: Kansas

WELL COMMENCED: October 5, 1979 WELL COMPLETED: October 19, 1979

ELEVATION: 2820' K.B. TOTAL DEPTH: 4650'

PRODUCTION: D & A RIG NO: #2

CASING - 8-5/8": 300.22' of 28# cemented with 225 sxs 60-40 poz 2% gel 3% cc  
5-1/2": none

ALL MEASUREMENTS TAKEN FROM THE TOP OF ROTARY BUSHING:

FROM	TO	FORMATION	DEVIATION FROM VERTICAL	REMARKS:	
0'	309'	surface sand and clay			
309'	738'	sand and shale			
738'	1584'	shale and sand			
1584'	1864'	shale			
1864'	1864'	shale			
1864'	1975'	shale			
1975'	2255'				
2149'	2184'	Anhydrite			
2250'	2428'	lime and shale			
2428'	2633'	shale			
2633'	2814'	shale and lime			
2814'	2971'	lime and shale			
2971'	3100'	shale and lime			
3100'	3260'	shale and lime			
3260'	3383'	lime and shale			
3383'	3519'	lime and shale			
3519'	3638'	shale and lime			
3638'	3738'	shale and lime			
3738'	3852'	shale and lime			
3852'	3957'	shale and lime			
3957'	4044'	shale and lime			
4044'	4105'	lime and shale			
4105'	4178'	shale and lime			
4178'	4238'	lime and shale	4404'	4446'	lime and shale
4238'	4267'	lime and shale	4446'	4490'	lime
4267'	4330'	shale and lime	4490'	4537'	lime and shale
4330'	4347'		4537'	4585'	lime
4347'	4347'	lime	4585'	4632'	lime
4347'	4404'	lime and shale	4632'	4650'	lime and shale
STATE OF KANSAS			4650'	RTD	
COUNTY OF					

The undersigned hereby certifies that to the best of his knowledge and belief, the above facts are true and correct

PIONEER DRILLING CO., INC.

By Charles G. Honea

SUBSCRIBED AND SWORN TO, BEFORE ME, This 22<sup>nd</sup> day of Oct., 1979.

Connie Jo Austin  
NOTARY PUBLIC

