


15-195-20471-0000

STATE OF KANSAS
STATE CORPORATION COMMISSION

Form CP-4

WELL PLUGGING RECORD

Give All Information Completely
Make Required Affidavit
Mail or Deliver Report to:
Conservation Division
State Corporation Commission
P. O. Box 17027
Wichita, Kansas 67217
NORTH

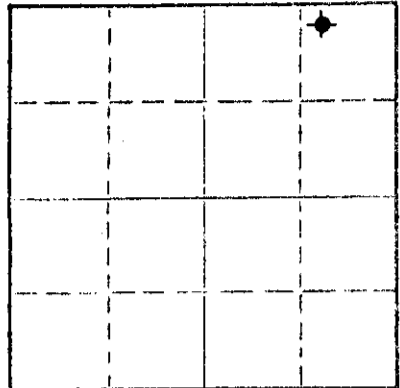

Locate well correctly on above
Section Plat

Trego County, Sec. 9 Twp. 13S Rge. 21W (E) (W)
Location as "NE/CNW/SE/SW" or footage from lines NW NE NE/4
Lease Owner Southern States Oil Company
Lease Name Keller Well No. 2
Office Address P.O. Box 1365, Great Bend, Kansas 67530
Character of Well (completed as Oil, Gas or Dry Hole) Oil
Date well completed June 17, 19 83
Application for plugging filed July 26, 19 83
Application for plugging approved August 3, 19 83
Plugging commenced November 17, 19 83
Plugging completed November 17, 19 83
Reason for abandonment of well or producing formation Deleted

If a producing well is abandoned, date of last production 19
Was permission obtained from the Conservation Division or its agents before plugging was commenced? Yes

Name of Conservation Agent who supervised plugging of this well Gilbert Scheck
Producing formation _____ Depth to top _____ Bottom _____ Total Depth of Well 3925 Feet
Show depth and thickness of all water, oil and gas formations.

OIL, GAS OR WATER RECORDS

CASING RECORD

FORMATION	CONTENT	FROM	TO	SIZE	PUT IN	PULLED OUT
				8-5/8"	273'	None
				4-1/2"	3905'	None

Describe in detail the manner in which the well was plugged, indicating where the mud fluid was placed and the method or methods used in introducing it into the hole. If cement or other plugs were used, state the character of same and depth placed, from _____ feet to _____ feet for each plug set.

Tied on to 4-1/2" casing.
Used 4 sacks hulls, 15 sacks gel, 4-1/2" rubber plug, and 165 sacks 50/50 Pozmix, 3%cc, 4% gel.
Got hulls, gel, plug and 140 sacks cement in hole. Pressured up to 2000 lbs. Shut in. Pumped 25 sacks cement down backside down annulus between 4-1/2" casing and 8-5/8".

RECEIVED
STATE CORPORATION COMMISSION
DEC 9 1983

Name of Plugging Contractor Sun Oilwell Cementing
Address P.O. Box 169, Great Bend, Kansas 67530

STATE OF Kansas COUNTY OF Barton ss.
Claude Blakesley (employee of owner) or (owner or operator) of the above-described well, being first duly sworn on oath, says: That I have knowledge of the facts, statements, and matters herein contained and the log of the above-described well as filed and that the same are true and correct. So help me God.

(Signature) Claude Blakesley
P.O. Box 1365, Great Bend, Ks. 67530
(Address)

NOTARY PUBLIC State of Kansas
NADINE K. NEWKIRK
My Appt. Exp. June 24, 1985
My commission expires

8th day of December 19 83
Nadine K. Newkirk
Notary Public.

DRILLERS LOG

No. 2 Keller ✓

CASING RECORD:

8 5/8" @ 273'
w/165 sx cmt.
4 1/2" @ 3,903'
w/800 sx cmt.

COMPANY: Frontier Oil Company
CONTRACTOR: Red Tiger Drilling Company
COMMENCED: May 5, 1978
COMPLETED: May 20, 1978

DESCRIPTION:

C NW/4 NE/4 NE/4
Sec. 9-T13S-R21W
Trego County, Kansas

TOTAL DEPTH: 3,905'

ELEVATION: 2,189' KB

<u>FORMATION</u>	<u>FROM</u>	<u>TO</u>	<u>REMARKS</u>
Shale	0	280	
Shale & Red Bed	280	1016	
Sand	1016	1295	
Shale	1295	1578	
Anhydrite	1578	1624	
Shale	1624	1850	
Shale w/Lime Streaks	1850	2255	
Shale & Lime	2255	2445	
Shale w/Lime Streaks	2445	2560	
Shale & Lime	2560	2955	
Lime & Shale	2955	3140	
Shale & Lime	3140	3275	
Lime	3275	3905	
RTD		3905	


I certify that this is a true and correct copy of the above log to the best of my knowledge.

RED TIGER DRILLING COMPANY

Gloria Fawcett
Gloria Fawcett

Subscribed and sworn to before me this 22nd day of May, 1978.

Joyce A. Hagermann
Notary Public

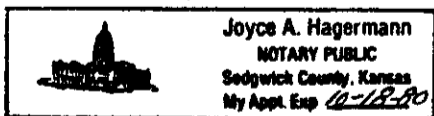

RECEIVED
STATE CORPORATION COMMISSION

AUG 01 1983

REGISTRATION DIVISION
Wichita, Kansas