


15-077-20006-0000

RECEIVED

MAR 11 1970
3-11-70
CONSERVATION DIVISION
Wichita, Kansas

WELL PLUGGING RECORD

Give All Information Completely
Make Required Affidavit
Mail or Deliver Report to:
Conservation Division
State Corporation Commission
212 No. Market
Wichita, Kansas

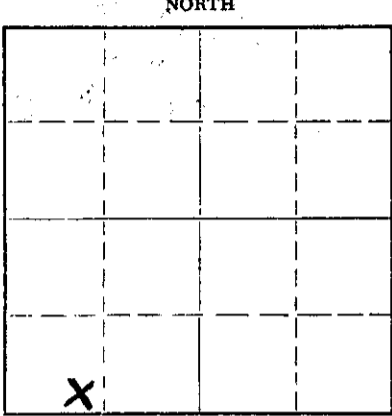

Locate well correctly on above Section Plat

Harper County. Sec 29 Twp. 31 Rge. 8 (E) W (W)
Location as "NE/CNW/SW" or footage from lines SE SW SW
Lease Owner Pickrell Drilling Co. Wichita, Kansas
Lease Name Asper "A" Well No. #1
Office Address 705 Fourth National Bank Building
Character of Well (completed as Oil, Gas or Dry Hole) Oil
Date well completed March 13 1967
Application for plugging filed January 19 70
Application for plugging approved January 19 70
Plugging commenced February 3 19 70
Plugging completed February 6 19 70
Reason for abandonment of well or producing formation Depleted

If a producing well is abandoned, date of last production January 22 19 70
Was permission obtained from the Conservation Division or its agents before plugging was commenced? Yes

Name of Conservation Agent who supervised plugging of this well Russell Biberstein
Producing formation Mississippi Depth to top 4341 Bottom 4354 Total Depth of Well 4356 Feet
Show depth and thickness of all water, oil and gas formations.

OIL, GAS OR WATER RECORDS

CASING RECORD

FORMATION	CONTENT	FROM	TO	SIZE	PUT IN	PULLED OUT
				8 5/8	210	None
				5 1/2	4347	3465

Describe in detail the manner in which the well was plugged, indicating where the mud fluid was placed and the method or methods used in introducing it into the hole. If cement or other plugs were used, state the character of same and depth placed, from feet to feet for each plug set.

February 3, 1970 Plugged off bottom. Dumped sand to 4300'. Mixed and dumped 5 sx of cement to 4260'.
February 6, 1970 Plugged off top. Set 10' rock bridge from 195' to 205'. Mixed and dumped 25 sx of cement. Mudded casing to 40'. Set 10' rock bridge from 40' to 30'. Mixed and dumped 10 sx of cement from 30' to base of cellar.

(If additional description is necessary, use BACK of this sheet)

Name of Plugging Contractor RUSS CASING PULLING, INC.
Address P. O. BOX 1082 GREAT BEND, KANSAS 67530

STATE OF Kansas, COUNTY OF Sedgwick, ss.
Dale M. Robinson (employee of owner) or (owner or operator) of the above-described well, being first duly sworn on oath, says: That I have knowledge of the facts, statements, and matters herein contained and the log of the above-described well as filed and that the same are true and correct. So help me God.

(Signature) Dale M. Robinson
705 Fourth National Bank Bldg., Wichita, Kansas (Address)

ESTHER LAMONE
NOTARY PUBLIC
My Commission Expires January 19, 1973
SEDGWICK COUNTY, KANSAS

Esther Lamone
Notary Public.

15-077-20006-0000
ROTARY DRILLING LOG

COMPANY: **Pickrell Drilling Company**
705 Fourth National Bank Bldg.
Wichita, Kansas

Rotary Drilling Commenced 2/19/67

Rotary Drilling Completed 2/28/67

LOCATION: **Asper "A" No. 1**
SE SW SW Section 29-31S-8W
Harper County, Kansas

CONTRACTOR: **PICKRELL DRILLING COMPANY**
Wichita, Kansas

CASING RECORD: (8 jts.) 8 5/8" surface casing set at 210' and cemented with 155 sacks cement. (135 jts.) 5 1/2" casing set at 4347' and cemented with 125 sacks cement. Circulated. Completed @ 10:40 PM, Feb. 28, 1967.

LOG

(Figures indicate bottom of formation — measurements from top of rotary bushing.)

25	Sand
211	Red Rock
830	Shale
1370	Shale, Shells & Lime
1830	Lime & Shale
1975	Lime
3925	Lime & Shale
4030	Lime
4349	Shale & Lime
4356	Mississippian, RTD

C.F.S.
4349'
4356'

RECEIVED
STATE CORPORATION COMMISSION
1-30-70
JAN 30 1970
CONSERVATION DIVISION
Wichita, Kansas

Slope Tests
3000
3500
4000

S.L.M.
None

The undersigned, C. W. SEBITS, Attorney-in-Fact for PICKRELL DRILLING COMPANY, hereby certifies in behalf of said Company, that the above is a true and correct log of the formation encountered in drilling the above well as reflected by the Daily Drilling Reports.

PICKRELL DRILLING COMPANY

By *C. W. Sebits*
C. W. SEBITS Attorney-in-Fact

STATE OF KANSAS }
COUNTY OF SEDGWICK } ss.:

On this 8th day of March, 1967, before me the undersigned, a Notary Public, in and for

the County and State aforesaid, personally appeared C. W. SEBITS, to me known to be the identical person who subscribed the name of PICKRELL DRILLING COMPANY to the foregoing instrument as its Attorney-in-Fact and acknowledged to me that he executed the same as his free and voluntary act and deed, and as the free and voluntary act and deed of such company, for the uses and purposes therein set forth.

Given under my hand and seal of office the day and year last above written.

My commission expires: May 10, 1970

L. M. Whiting
L. M. Whiting Notary Public