

15-077-20048-0000


STATE OF KANSAS
STATE CORPORATION COMMISSION

Form CP-4

Give All Information Completely
Make Required Affidavit
Mail or Deliver Report to:
Conservation Division
State Corporation Commission
212 No. Market
Wichita, Kansas

WELL PLUGGING RECORD

NORTH

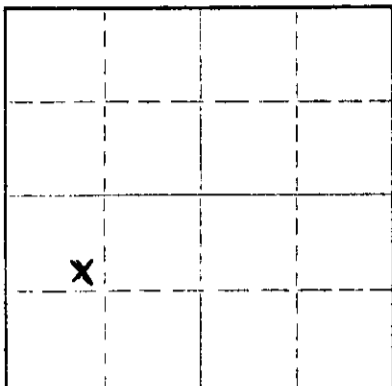

Locate well correctly on above
Section Plat

Harper County. Sec 29 Twp. 31S Rge. 8 (E) W (W)
Location as "NE/CNW/SW" or footage from lines SE NW SW
Lease Owner Pickrell Drilling Co., Wichita, Kansas
Lease Name Broce A Well No. #3
Office Address 705 Fourth National Bank Bldg.
Character of Well (completed as Oil, Gas or Dry Hole) Oil
Date well completed May 4 19 68
Application for plugging filed July 8 19 69
Application for plugging approved July 10 19 69
Plugging commenced July 10 19 69
Plugging completed July 16 19 69
Reason for abandonment of well or producing formation Depleted

If a producing well is abandoned, date of last production July 16 19 69
Was permission obtained from the Conservation Division or its agents before plugging was commenced? Yes

Name of Conservation Agent who supervised plugging of this well Ralph Warren
Producing formation Mississippian Depth to top 4353 Bottom 4371 Total Depth of Well 4371 Feet
Show depth and thickness of all water, oil and gas formations.

OIL, GAS OR WATER RECORDS

CASING RECORD

FORMATION	CONTENT	FROM	TO	SIZE	PUT IN	PULLED OUT
				8 5/8	218	None
				5 1/2	4365	3301

RECEIVED
STATE CORPORATION COMMISSION
AUG 5 1969
CONSERVATION DIVISION
Wichita, Kansas

Describe in detail the manner in which the well was plugged, indicating where the mud fluid was placed and the method or methods used in introducing it into the hole. If cement or other plugs were used, state the character of same and depth placed, from _____ feet to _____ feet for each plug set.

7 - 10 - 69 Plugged off bottom. Dumped sand to 4350'. Mixed and dumped 5 sx of cement to 4300'.

7 - 16 - 69 Plugged off surface. Pushed plug to 218'. Set 10' rock bridge from 218' to 208'. Mixed and dumped 25 sx of cement from 208' to 133'. Mudded casing to 40' and set 10' rock bridge from 40' to 30'. Mixed and dumped 10 sx of cement from 30' to base of cellar.

(If additional description is necessary, use BACK of this sheet)
Name of Plugging Contractor Russ Casing Pulling, Inc.
Address P. O. Box 1082 Great Bend, Kansas 67530

STATE OF Kansas, COUNTY OF Sedgwick, ss.

Dale M. Robinson (employee of owner) or (owner or operator) of the above-described


well, being first duly sworn on oath, says: That I have knowledge of the facts, statements, and matters herein contained and the log of the above-described well as filed and that the same are true and correct. So help me God.

(Signature) Dale M. Robinson
705 - 4th National Bldg., Wichita, Kansas
(Address)

SUBSCRIBED AND SWORN TO before me this 4th day of August, 19 69

Esther Lamone
Esther Lamone Notary Public.

My commission expires Jan. 19, 1969

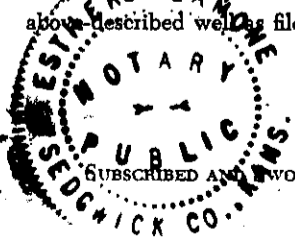

15-07720848-0000
ROTARY DRILLING LOG

COMPANY: Pickrell Drilling Company
705 4th National Bank Bldg.
Wichita, Kansas

Rotary Drilling Commenced 3/6/68

Rotary Drilling Completed 3/14/68

LOCATION: Broce "A" No. 3, 100' W of SE NW SW Section 29-3[S-8W, Harper County, Kansas.

CONTRACTOR: **PICKRELL DRILLING COMPANY**
Wichita, Kansas

CASING RECORD: (10 jts) 218' of 8 5/8" surface casing set with 145 sacks cement. Circulated. (136 jts) 5 1/2" casing set at 4365' with 125 sacks cement. Completed 11:45 P.M. March 14, 1968.

LOG

(Figures indicate bottom of formation — measurements from top of rotary bushing.)

220	Red Rock & Cement	C. F. S.
400	Red Rock & Shale	<u>4358</u>
1300	Shale	4370
3335	Shale & Lime	
3530	Shale	
3635	Shale & Sandy Lime	
3947	Lime & Shale	
4035	Lime	<u>Slope Tests</u>
4353	Shale & Lime	2000
4370	Mississippi Chert, RTD	2500
		3000
		3500
		4000

	S. L. M.
Board	<u>4047.35</u>
Strap	4044.64

Difference 2.71

RECEIVED
STATE CORPORATION COMMISSION
7-10-69
JUL 10 1969
CONSERVATION DIVISION
Wichita, Kansas

The undersigned, C. W. SEBITS, Attorney-in-Fact for PICKRELL DRILLING COMPANY, hereby certifies in behalf of said Company, that the above is a true and correct log of the formation encountered in drilling the above well as reflected by the Daily Drilling Reports.

PICKRELL DRILLING COMPANY

By C. W. Sebits Attorney-in-Fact

STATE OF KANSAS }
COUNTY OF SEDGWICK } ss.:

On this 25 day of March, 1968, before me the undersigned, a Notary Public, in and for the County and State aforesaid, personally appeared C. W. SEBITS, to me known to be the identical person who subscribed the name of PICKRELL DRILLING COMPANY to the foregoing instrument as its Attorney-in-Fact and acknowledged to me that he executed the same as his free and voluntary act and deed, and as the free and voluntary act and deed of such company, for the uses and purposes therein set forth.

Given under my hand and seal of office the day and year last above written.

My commission expires: May 10, 1970

L. M. Whiting
L. M. WHITING Notary Public