


Give All Information Completely  
Make Required Affidavit  
Mail or Deliver Report to:  
Conservation Division  
State Corporation Commission  
212 No. Market  
Wichita, Kansas

WELL PLUGGING RECORD

NORTH

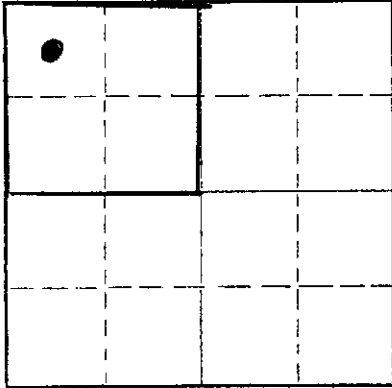

Locate well correctly on above  
Section Plat

Harper County. Sec. 29 Twp. 31S Rge. (E) 8 (W)  
Location as "NE/CNW/SW" or footage from lines C/NW/4 NW/4  
Lease Owner **Forrest H. Lindsay - National Associated Petroleum**  
Lease Name **R. C. Broce** Well No. **1**  
Office Address **Fifth Floor, Ritz Building, Tulsa, Oklahoma**  
Character of Well (completed as Oil, Gas or Dry Hole) **Dry Hole**  
Date well completed **October 7 1965**  
Application for plugging filed **October 7 (Verbal) 1965**  
Application for plugging approved **October 7 (Verbal) 1965**  
Plugging commenced **October 7 1965**  
Plugging completed **October 7 1965**  
Reason for abandonment of well or producing formation **Dry Hole**

If a producing well is abandoned, date of last production \_\_\_\_\_ 19\_\_\_\_  
Was permission obtained from the Conservation Division or its agents before plugging was commenced? **Yes**

Name of Conservation Agent who supervised plugging of this well \_\_\_\_\_  
Producing formation \_\_\_\_\_ Depth to top \_\_\_\_\_ Bottom \_\_\_\_\_ Total Depth of Well **4468** Feet  
Show depth and thickness of all water, oil and gas formations.

OIL, GAS OR WATER RECORDS

CASING RECORD

FORMATION	CONTENT	FROM	TO	SIZE	PUT IN	PULLED OUT

Describe in detail the manner in which the well was plugged, indicating where the mud fluid was placed and the method or methods used in introducing it into the hole. If cement or other plugs were used, state the character of same and depth placed, from \_\_\_\_\_ feet to \_\_\_\_\_ feet for each plug set.

Plug @ 200' W 25 sacks cement  
1 sack hulls - Plug @ 40' with  
12 sacks cement - 3 sacks cement in Rathole

RECEIVED  
STATE CORPORATION COMMISSION

APR 13 1966  
4-13-66  
CONSERVATION DIVISION  
Wichita, Kansas

(If additional description is necessary, use BACK of this sheet)  
Name of Plugging Contractor **Thoroughbred Drilling Company**  
Address **517 Ritz Building, Tulsa, Oklahoma**

STATE OF OKLAHOMA, COUNTY OF TULSA, ss.  
Dan W. Brown - **Thoroughbred Drilling Company** (employee of owner) or (owner or operator) of the above-described well, being first duly sworn on oath, says: That I have knowledge of the facts, statements, and matters herein contained and the log of the above-described well as filed and that the same are true and correct. So help me God.

(Signature) Dan W. Brown  
517 Ritz Building, Tulsa, Oklahoma  
(Address)

SUBSCRIBED AND SWORN TO before me this 11th day of April, 19 66

My commission expires February 21, 1969  
Maxine D. Provine  
Maxine D. Provine Notary Public.



517 RITZ BUILDING TELEPHONE LU 2-1181

DRILLER'S LOG

Roy C. Broce #1  
C/NW/4 NW/4 Section 29-31S-8W  
Harper County, Kansas

National Associated Petroleum Co.  
Thoroughbred Drilling Co.

0'	-	161'	Sand Gravel Shale
161'	-	1140'	Red Bed & Shale
1140'	-	3780'	Lime & Shale
3780'	-	4340'	Lime
4340'	-	4446'	Lime & Shale
4446'	-	4468'	Mississippi Chat & Lime

THOROUGHBRED DRILLING CO.

Daniel W. Brown

RECEIVED  
STATE CORPORATION COMMISSION

APR 13 1966  
4-13-66  
CONSERVATION DIVISION  
Wichita, Kansas