


15-077-10086-0000

WELL PLUGGING RECORD

Give All Information Completely
Make Required Affidavit
Mail or Deliver Report to:
Conservation Division
State Corporation Commission
211 No. Broadway
Wichita, Kansas

Harper County. Sec. 31 Twp. 31S Rge. 8 (E) W (W)

Location as "NE/CNW/SW4" or footage from lines SW NW NW
Lease Owner Socony Mobil Oil Company, Inc.
Lease Name Wm. L. Carr Well No. 1
Office Address 300 No. Broadway - Wichita, Kansas - 67202
Character of Well (completed as Oil, Gas or Dry Hole) Oil (SWDW)
Date well completed 7-19-54 19__
Application for plugging filed 1-29-64 19__
Application for plugging approved 1-30-64 19__
Plugging commenced 2-10-64 19__
Plugging completed 2-13-64 19__
Reason for abandonment of well or producing formation Depleted

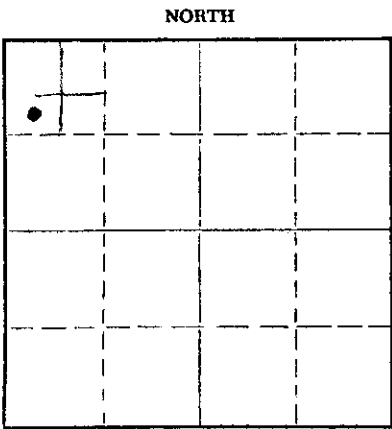

Locate well correctly on above Section Plat

If a producing well is abandoned, date of last production October 19 57
Was permission obtained from the Conservation Division or its agents before plugging was commenced? Yes

Name of Conservation Agent who supervised plugging of this well Archie Elving
Producing formation Mississippi Depth to top 4355 Bottom 4460' Total Depth of Well 4460' Feet
Show depth and thickness of all water, oil and gas formations.

OIL, GAS OR WATER RECORDS

CASING RECORD

FORMATION	CONTENT	FROM	TO	SIZE	PUT IN	PULLED OUT
Mississippi	Oil	4383	4398'	9 5/8"	255'	0
				5 1/2"	4359'	3215'

Describe in detail the manner in which the well was plugged, indicating where the mud fluid was placed and the method or methods used in introducing it into the hole. If cement or other plugs were used, state the character of same and depth placed, from _____ feet to _____ feet for each plug set.

Dump sand from 4422 to 4372'. Mixed and dumped 5 sk cement 4372' to 4345'. Pulled 104 jts of 5 1/2" csg. Set plug in surface csg at 270'. Made rock bridge from 270 to 260. Mixed and dumped 35 sk of cement from 260 to 185'. Mudded hole from 185' to 40'. Set 10' rock bridge from 40' to 30'. Mixed & dumped 12 sack cement from 30' to base of cellar.

RECEIVED
STATE CORPORATION COMMISSION
FEB 28 1964
2-28-64
CONSERVATION DIVISION
Wichita, Kansas

(If additional description is necessary, use BACK of this sheet)
Name of Plugging Contractor Ace Pipe Pulling Company
Address P. O. Box 304, Great Bend, Kansas

STATE OF Kansas, COUNTY OF Sedgwick, ss.
T. V. Herriage (employee of owner) or (owner or operator) of the above-described well, being first duly sworn on oath, says: That I have knowledge of the facts, statements, and matters herein contained and the log of the above-described well as filed and that the same are true and correct. So help me God.

(Signature) T. V. Herriage Dist. Office Acctg Group Supv.
300 No. Broadway - Wichita, Kansas - 67202
(Address)

SUBSCRIBED AND SWORN TO before me this 26 day of February, 19 64

My commission expires 4-4-66 Jack Bearden Notary Public.

KANSAS GEOLOGICAL SOCIETY
 KANSAS GEOLOGICAL SOCIETY BUREAU - KANSAS WELL SURVEY BUREAU
 KANSAS GEOLOGICAL SOCIETY BUILDING
 508 EAST MURDOCK - WICHITA, KANSAS

15-077-10086-0000


COMPANY **MAGNOLIA PETROLEUM CO.**

SEC. 31 T. 31S R. 8W
 LOC. SW NW NW

FARM **W. L. Carr** NO. **1**

COUNTY

KANSAS

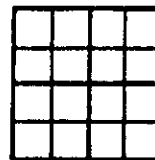

TOTAL DEPTH **4460**
 COMM. Spudded **6/20/54** COMP. **7/27/54**
 SHOT OR TREATED
 CONTRACTOR **Prime Drilling Co.**
 ISSUED

CASING

20 **1 1/2" 9 5/8" @ 255' & cem. w/225 sacks**
 15 **8**
 12 **6**
 13 **5 1/2" @ 4459' & cem. w/200 sacks**

ELEVATION **1555 D.F.**

PRODUCTION
**P re 80 & 20 BSW in
 24 hrs. Gr. 31.4°**

FIGURES INDICATE BOTTOM OF FORMATIONS

Sand & Clay	50
Red Bed & Shale	255
Shale & Shells	1315
Anhydrite	1330
Shale & Shells	1500
Shale & Lime	1595
Lime & Shale	1665
Lime W/Shale Breaks	3225
Lime (Sandy Shale)	3320
Lime & Shale	3395
Lime W/Shale Breaks	3440
Lime & Shale	3595
Lime	3675
Lime & Shale Breaks	3890
Lime W/Shale Breaks	3968
Lime	4005
Shale	4295
Shale W/Lime	4355
Lime (Miss.)	4460

TOPS:

Mississippi **4375**

DST #1 **4374-4406**, open 1 hr., SI 30 min., gas to surface in 5 min., rec. 1620' gassy oil, 235' HO & GCM, 125' water (chiefly filtrate FP 93# - 387#, SI 30 min., BHP 1345# (Still bldg.))

DST #2 **4406-20**, open 1 hr., SI 30 min., strong blow decreasing to fair blow, rec. 570' g-s, 90' GC & SOCM, 240' water, FP 42# - 139#, 30 min. SIBHP 1495#

RECEIVED
 STATE CORPORATION COMMISSION

MAR 3 1964
 3-3-64
 CONSERVATION DIVISION
 Wichita, Kansas