


STATE OF KANSAS
STATE CORPORATION COMMISSION

Form CP-4

Give All Information Completely
Make Required Affidavit
Mail or Deliver Report to:
Conservation Division
State Corporation Commission

WELL PLUGGING RECORD

P. O. Box 17027
Wichita, Kansas 67217
NORTH

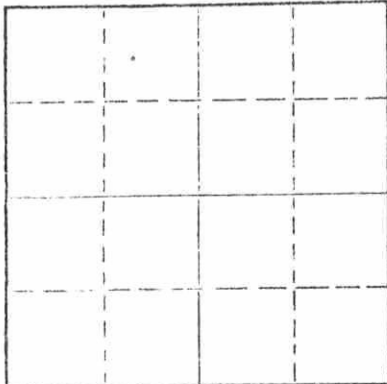

Locate well correctly on above
Section Plat

Harper County, Sec. 31 Twp. 31 Rge. 8 (E) (W) X
Location as "NE/CNW&SW" or footage from lines NW/SE/NE
Lease Owner Mull Drilling Co.
Lease Name CARR "C" Well No. 1
Office Address Box 328, Attica, Kansas 67009
Character of Well (completed as Oil, Gas or Dry Hole)
Date well completed 19
Application for plugging filed May 1, 19 74
Application for plugging approved 19
Plugging commenced June 10, 19 74
Plugging completed June 25, 19 74
Reason for abandonment of well or producing formation Depleted
If a producing well is abandoned, date of last production 19
Was permission obtained from the Conservation Division or its agents before plugging was commenced? Yes

Name of Conservation Agent who supervised plugging of this well G. R. Biberstein
Producing formation Depth to top Bottom Total Depth of Well 4350 Feet
Show depth and thickness of all water, oil and gas formations.

OIL, GAS OR WATER RECORDS

CASING RECORD

FORMATION	CONTENT	FROM	TO	SIZE	PUT IN	PULLED OUT
				8 5/8	201	0
				5 1/2	4343	3386.10'

Describe in detail the manner in which the well was plugged, indicating where the mud fluid was placed and the method or methods used in introducing it into the hole. If cement or other plugs were used, state the character of same and depth placed, from feet to feet for each plug set.


Measured T.D. at 4350'. Dumped sand to 4300' and 5 sacks cement.
Shot casing at 3775, 3600, 3500, 3425'. Pulled a total of 105 joints
of 5 1/2" casing. Pushed a plug to 250' and built a 15' rock bridge.
Plugged well with 5 yds. readymix concrete.

RECEIVED
STATE CORPORATION COMMISSION
JUN 27 1974
6-27-74
CONSERVATION DIVISION
Wichita, Kansas

(If additional description is necessary, use BACK of this sheet)
Name of Plugging Contractor Rockhold Engineering, Inc.
Address Box 698, Great Bend, Kansas 67530

STATE OF Kansas COUNTY OF Barton, ss.
James W. Rockhold (employee of owner) or (owner or operator) of the above-described well, being first duly sworn on oath, says: That I have knowledge of the facts, statements, and matters herein contained and the log of the above-described well as filed and that the same are true and correct. So help me God.

(Signature) James W. Rockhold
Box 698, Gt. Bend, Ks. 67530 James W. Rockhold
(Address)

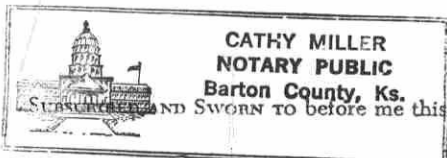

26th day of June, 19 74
Cathy Miller
Notary Public.

My commission expires September 30, 1975

#1 CARR "C"

Mull Drilling Company

Total depth: 4350'

Elevation: 1514 GL 1519 KB

Contractor: Donelson Drilling Co.

Location: NW SE NE, Sec. 31-31S-8W

Commenced: 4/19/67

Harper County, Kansas

Completed: 4/27/67

Casing Record: 201.50' new 8 5/8"
set @ 208.50' KB w/170 sks. cmt.

Formation:

Depth:

Surface hole

210'

Shale

1350'

Lime & Shale stks.

1700'

Lime & Shale

2150'

Shale & Lime

3350'

Lime & Shale

3420'

Shale & Sand

3465'

Lime & Shale

3948'

Lime

4180'

Lime & Shale

4276'

Lime

4341'

Chert

4350 TD

RECEIVED
STATE CORPORATION COMMISSION
MAY 2 - 1974
5-2-74
CONSERVATION DIVISION
Wichita, Kansas

I hereby certify the foregoing statements are true and correct to the best of my knowledge and belief.

DONELSON DRILLING COMPANY

James L. Donelson
James L. Donelson

STATE OF KANSAS)
) SS
COUNTY OF SEDGWICK)

Subscribed and sworn to before me, a Notary Public in and for said county and state, this 28th day of April, 1967.

Carolyn L. Scott
Carolyn L. Scott, Notary Public

My Commission expires: April 16, 1969