


15-165-02195-0000

WELL PLUGGING RECORD

Give All Information Completely  
Make Required Affidavit  
Mail or Deliver Report to:  
Conservation Division  
State Corporation Commission  
211 No. Broadway  
Wichita, Kansas

NORTH

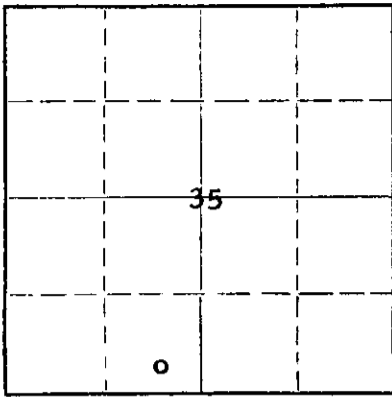

Locate well correctly on above  
Section Plat

Rush County. Sec. 35 Twp. 18 Rge. 16 (EX (W)  
Location as "NE/CNW&SW&" or footage from lines SE SE SW  
Lease Owner Hilton Drilling Company, Inc.  
Lease Name Budde Well No. 1  
Office Address P. O. Box 108, Great Bend, Kansas  
Character of Well (completed as Oil, Gas or Dry Hole) dry hole  
Date well completed October 6, 19 57  
Application for plugging filed October 6, 19 57  
Application for plugging approved October 6, 19 57  
Plugging commenced October 6, 19 57  
Plugging completed October 6, 19 57  
Reason for abandonment of well or producing formation dry hole

If a producing well is abandoned, date of last production \_\_\_\_\_ 19\_\_\_\_  
Was permission obtained from the Conservation Division or its agents before plugging was commenced? yes

Name of Conservation Agent who supervised plugging of this well W. H. Brundege  
Producing formation \_\_\_\_\_ Depth to top \_\_\_\_\_ Bottom \_\_\_\_\_ Total Depth of Well 3635 Feet  
Show depth and thickness of all water, oil and gas formations.

OIL, GAS OR WATER RECORDS

CASING RECORD

FORMATION	CONTENT	FROM	TO	SIZE	PUT IN	PULLED OUT
				8-5/8"	1036'	none

Describe in detail the manner in which the well was plugged, indicating where the mud fluid was placed and the method or methods used in introducing it into the hole. If cement or other plugs were used, state the character of same and depth placed, from \_\_\_\_\_ feet to \_\_\_\_\_ feet for each plug set.

Filled hole with drilling mud to 300' and set plug with 20 sacks of cement, filled hole to 35' with mud and set plug with 1/2 sack bulls and 10 sacks cement to surface

(If additional description is necessary, use BACK of this sheet)  
Name of Plugging Contractor Hilton Drilling Company, Inc.  
Address Great Bend, Kansas

STATE OF KANSAS, COUNTY OF BARTON, ss.  
Jack L. Craft, Assistant Secretary (employee of owner) or (owner or operator) of the above-described well, being first duly sworn on oath, says: That I have knowledge of the facts, statements, and matters herein contained and the log of the above-described well as filed and that the same are true and correct. So help me God.

(Signature) Jack L. Craft  
Great Bend, Kansas  
(Address)

SUBSCRIBED AND SWORN TO before me this 8th day of October 19 57

My commission expires \_\_\_\_\_  
MILDRED HOBBIE  
MY COMMISSION EXPIRES MARCH 6, 1958  
Notary Public.

PLUGGING  
FILE SEC 39 T 18 R 16W  
BOOK PAGE 51 LINE 29

15-165-00195-0000

DRILLER'S LOG

COMPANY: HILTON DRILLING COMPANY, INC., & MISSION OIL COMPANY

LOCATION: SE SE SW SECTION 35-18-16W RUSH COUNTY, KANSAS

CONTRACTOR: HILTON DRILLING COMPANY, INC.

ELEVATION: 1978 DF

FARM NAME: BUDE No. 1

CASING USED: 8 5/8" @ 1036' w/250 PERMIX w/250 HEUCE

COMMENCED: 9-26-57

COMPLETED: 10-6-57

CLAY	46
SAND	70
SHALE	125
LIMY SHALE AND LIMY SAND	388
SHALE AND SHELL	428
SAND	528
SHALE AND SHELL	588
SAND	625
SHALE AND SHELL	708
RED BED	738
RED BED AND SHELLS	1038
SHALE, RED BED AND ANHYDRITE	1058
ANHYDRITE	1135
RED BED AND SHALE	1585
SHALE AND SHELLS	1708
LIME AND SHALE	2935
SHALE AND SHELLS	3010
LIME	3285
LIME AND SHALE	3288
LIME	3298
LIME AND SHALE	3388
LIME	3500
CONGLOMERATE	3618
SAND AND LIME	3620
LIME	3635
TOTAL DEPTH	3635

STATE OF KANSAS )  
 COUNTY OF BARTON ) ss.

I, THE UNDERSIGNED, BEING DULY SWORN ON OATH, STATE THAT THE ABOVE STATEMENT AND LOG ARE TRUE AND A CORRECT RECORD AND LOG OF THE WELL DRILLED AT THE LOCATION ABOVE DESCRIBED.

HILTON DRILLING COMPANY, INC.

*Jack L. Craft*  
 JACK L. CRAFT, ASST. SECRETARY

SUBSCRIBED AND SWORN TO BEFORE ME THIS 9TH DAY OF OCTOBER, 1957.

RECEIVED  
 STATE COMMISSION  
 OCT 10 1957  
 10-10-57  
 DIVISION

*Mildred Hobbie*  
 MILDRED HOBBI  
 MY COMMISSION EXPIRES MARCH 6, 1958  
 NOTARY PUBLIC

KY PLUGGING  
 FILE SEC. 29 T. 18 R. 16W  
 BOOK PAGE 51 LINE 29