

STATE OF KANSAS
STATE CORPORATION COMMISSION

Form CP-4

WELL PLUGGING RECORD

Give All Information Completely
Make Required Affidavit
Mail or Deliver Report to:
Conservation Division
State Corporation Commission
212 No. Market
Wichita, Kansas

Trego County. Sec. 9 Twp. 13S Rge. 21 (E) (W) **X**

Location as "NE/CNW/SW" or footage from lines NE/4

Lease Owner Heller Drilling Company, Inc.

Lease Name Keller Well No. 1-W

Office Address 1011 1/2 Union Center Wichita, Kansas

Character of Well (completed as Oil, Gas or Dry Hole) _____

Date well completed _____ 19__

Application for plugging filed 8-31-66 19__

Application for plugging approved 9-1-66 19__


Plugging commenced 9-10-66 19__

Plugging completed 9-14-66 19__

Reason for abandonment of well or producing formation _____

If a producing well is abandoned, date of last production _____ 19__

Was permission obtained from the Conservation Division or its agents before plugging was commenced? Yes

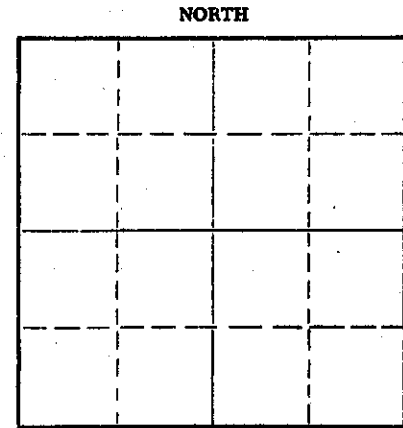

Locate well correctly on above Section Plat

Name of Conservation Agent who supervised plugging of this well W. L. Nichols

Producing formation _____ Depth to top _____ Bottom _____ Total Depth of Well 3887 Feet

Show depth and thickness of all water, oil and gas formations.

OIL, GAS OR WATER RECORDS

CASING RECORD

FORMATION	CONTENT	FROM	TO	SIZE	PUT IN	PULLED OUT
				8 5/8	208	None
				5 1/2	None	1003

Describe in detail the manner in which the well was plugged, indicating where the mud fluid was placed and the method or methods used in introducing it into the hole. If cement or other plugs were used, state the character of same and depth placed, from _____ feet to _____ feet for each plug set.

Moved in. Cleaned out cellar.

Rigged up. Working pipe. Sanded to 1100'. Dumped 5 sacks of cement. Pipe pulled into at approximately 1000'. Pulling pipe.

Pulling pipe.

Squeezed well with 10 sacks of gel mud and 100 sacks of bulk cement.

RECEIVED
STATE CORPORATION COMMISSION
SEP 27 1966
CONSERVATION DIVISION

(If additional description is necessary, use BACK of this sheet)

Name of Plugging Contractor Forbes Casing Pulling, Inc.

Address P. O. Box 221 Great Bend, Kansas

STATE OF Kansas, COUNTY OF Barton, ss.

J. O. Forbes (employee of owner) or (owner or operator) of the above-described well, being first duly sworn on oath, says: That I have knowledge of the facts, statements, and matters herein contained and the log of the above-described well as filed and that the same are true and correct. So help me God.

(Signature) J. O. Forbes
P. O. Box 221 Great Bend, Kansas
(Address)

SUBSCRIBED AND SWORN TO before me this 20 day of September, 1966

My commission expires May 27, 1969

(Alice) (Name) Notary Public.

DRILLER'S LOG

OWNER: Hellar Drilling Company, Inc.
 CONTRACTOR: Old hole of Harbar Oil & Gas Co. *Keller #2*
 LEASE: 1-W Keller SWDW
 LOCATION: NE/4 Sec. 9-13S-21W
 Trego County, Kansas

COMMENCED: January 1959 - Old hole of Harbar Oil & Gas Co.
 COMPLETED: 208' of 8 5/8" surface casing and
 CASING: 3887" of 5 1/2" casing

0-55	Soil & limestone shelves
50-205	Shale & sandy shale
205-340	shale & sand stringers
340-420	sand
420-465	shale
465-605	broken shale & sand
605-815	mostly shale, sand broken
815-845	Cheyenne Sand

RECEIVED
 STATE CORPORATION COMMISSION
 SEP 1 1966
 CONSERVATION DIVISION
 Wichita, Kansas

STATE OF KANSAS)
) SS
 COUNTY OF SEDGWICK)

I, D. L. Hellar,, do hereby certify that the above and foregoing is a true and correct copy of the log of the #1-W Keller SWDW located in NE/4 Sec. 9-13S-21W, Trego County, Kansas, as reflected by the files of the Hellar Drilling Company, Inc.

HELLAR DRILLING COMPANY, INC.

By *D. L. Hellar*
 D. L. Hellar - President

Subscribed and sworn to before me, a Notary Public, in and for Sedgwick County, Kansas, this 22nd day of March, 1963.

My Commission Expires:
 March 25, 1964.

Catherine Darcy
 Notary Public - Catherine Darcy

old TD 3900
 Harbar O & G #2 Keller
 SW-NE-NE 9-13-21
 Elev 2186 RB