


STATE OF KANSAS
STATE CORPORATION COMMISSION

WELL PLUGGING RECORD

Give All Information Completely
Make Required Affidavit
Mail or Deliver Report to:
Conservation Division
State Corporation Commission
800 Bittling Building
Wichita, Kansas

Harper County, Sec. 34 Twp. 31S Rge. 8 (8) W (W)

Location as "NE/CNW/SW" or footage from lines SW SE SW
Lease Owner Graybol Oil Corporation
Lease Name Wilson Well No. 1
Office Address 425 National Bank of Tulsa Bldg., Tulsa, Oklahoma
Character of Well (completed as Oil, Gas or Dry Hole) Dry Hole
Date well completed September 10 19 55
Application for plugging filed September 10 19 55
Application for plugging approved September 10 19 55
Plugging commenced September 10 19 55
Plugging completed September 10 19 55
Reason for abandonment of well or producing formation Dry Hole

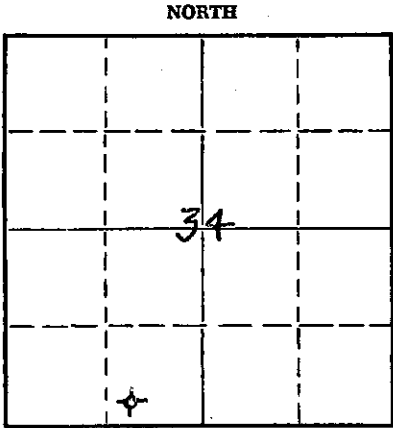

Locate well correctly on above
Section Plat

If a producing well is abandoned, date of last production _____ 19 ____
Was permission obtained from the Conservation Division or its agents before plugging was commenced? Yes

Name of Conservation Agent who supervised plugging of this well M. A. Rives, Pratt, Kansas
Producing formation _____ Depth to top _____ Bottom _____ Total Depth of Well 5005 Feet
Show depth and thickness of all water, oil and gas formations.

OIL, GAS OR WATER RECORDS

CASING RECORD

FORMATION	CONTENT	FROM	TO	SIZE	PUT IN	PULLED OUT
				10 3/4"	196'	None

Describe in detail the manner in which the well was plugged, indicating where the mud fluid was placed and the method or methods used in introducing it into the hole. If cement or other plugs were used, state the character of same and depth placed, from _____ feet to _____ feet for each plug set.

Hole filled with mud - set plug at 200' and placed one sack hulls, then 25 sacks cement, then filled to 25' with mud, then ran 10 sacks cement to top of surface casing.

(If additional description is necessary, use BACK of this sheet)

Name of Plugging Contractor Graybol Oil Corporation
Address 425 National Bank of Tulsa Bldg., Tulsa 3, Oklahoma

STATE OF OKLAHOMA, COUNTY OF TULSA, ss.
A. N. Ward (employee of owner) or (owner or operator) of the above-described well, being first duly sworn on oath, says: That I have knowledge of the facts, statements, and matters herein contained and the log of the above-described well as filed and that the same are true and correct. So help me God.

(Signature) [Signature]
425 Natl Bank of Tulsa, Tulsa, Ok (Address)

SUBSCRIBED AND SWORN TO before me this 13th day of September, 1955

My commission expires July 21, 1958
Merced J. Guston Notary Public.

PLUGGING
FILE SEC. 34 T. 31 S. R. 8 W.
BOOK PAGE 148 LINE 43

RECEIVED
STATE CORPORATION COMMISSION
SEP 14 1955
9-14-55
CONSERVATION DIVISION
Wichita, Kansas

GRAYBOL OIL CORPORATION

WILSON NO. 1

Contractor: Company Tools (Rotary)

Commenced: 8-20-55

SW SE SW

Completed: 9-10-55

HARPER COUNTY, KANSAS

Sec. 34, T.31-S, R.8W

Elev: 1503' D.F.

Production: Dry hole

CASING RECORD

Run:

196' 10 3/4" Surface Casing cemented with 180 sacks of cement.

DEPTH	STRATA	FORMATION TOPS	DEPTH
0 - 650	Surface, sandy shale	Kansas City Limestone	3868
650 - 1100	Shale	Mississippian	4360
1100 - 1430	Shale and Anhydrite	Kinderhook	4581
1430 - 1509	Sandy lime	Viola	4701
1509 - 1602	Lime and salt	Simpson Shale	4745
1602 - 1866	Lime and shale	Simpson sand	4753
1866 - 1980	Lime and salt	Arbuckle	4898
1980 - 2085	Lime and shale	Total Depth	5005
2085 - 2161	Shale and lime		
2161 - 2265	Lime and shale	D.S.T. 4363 - 4385, Open 2 hours,	
2265 - 2405	Shale and sand	Recovered 100' gas, 180' oil & gas-cut	
2405 - 2503	Sandy lime and shale	mud, 270' oily salt water and 530'	
2503 - 2819	Shale and lime	salt water. B.H.P. 810#/20 min.	
2819 - 2940	Shale		
2940 - 3221	Shale and lime		
3221 - 3375	Shale		
3375 - 3494	Shale and lime		
3494 - 3635	Sand and shale		
3635 - 3745	Sand		
3745 - 3825	Shale and lime		
3825 - 3897	Sandy shale		
3897 - 3922	Sand		
3922 - 4061	Lime		
4061 - 4128	Lime and shale		
4128 - 4375	Shale and lime		
4375 - 4385	Sand and lime		
4385 - 4584	Lime		
4584 - 4715	Shale and lime		
4715 - 4736	Lime and sand		
4736 - 4758	Lime		
4758 - 4807	Lime and sand		
4807 - 4854	Shale and lime		
4854 - 4885	Lime and shale		
4885 - 4915	Sand and lime		
4915 - 4963	Lime		
4963 - 5005	Sand and lime		
TOTAL DEPTH	5005		

I hereby certify that the above is a true and correct log of said well as reflected by the daily drilling reports.

GRAYBOL OIL CORPORATION

By: *Jack L. Grogan*

STATE OF OKLAHOMA, COUNTY OF TULSA, ss

Subscribed and sworn to before me this 13th day of September, 1955.

Medford A. Garton
Notary Public

My commission expires July 21, 1958.

PLUGGING
FILE SEC 34 T 31 R 8W
BOOK PAGE 148 LINE 43

DIVISION