


STATE OF KANSAS
STATE CORPORATION COMMISSION

Form CP-4

WELL PLUGGING RECORD

See All Information Completely
Also Required Affidavit
File or Deliver Report to:
Conservation Division
State Corporation Commission
211 No. Broadway
Wichita, Kansas

NORTH

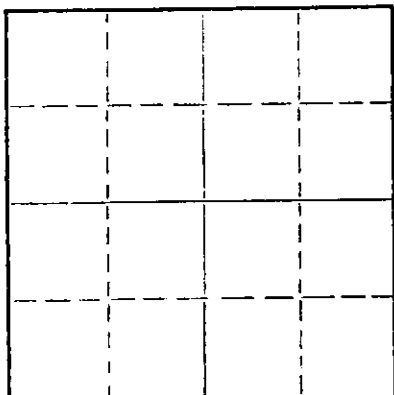

Locate well correctly on above
Section Plat

Harper County. Sec. 35 Twp. 31S Rge. (E)8 (W)
Location as "NE/CNWKSWK" or footage from lines C NW SE
Lease Owner Pickrell Drlg Company & Bradley Brothers
Lease Name Alford Well No. 1
Office Address 705 4th Natl Bank Bldg, Wichita, Kansas
Character of Well (completed as Oil, Gas or Dry Hole) Dry Hole
Date well completed May 15, 19 63
Application for plugging filed May 15, 19 63
Application for plugging approved May 15, 19 63
Plugging commenced May 15, 19 63
Plugging completed May 15, 19 63
Reason for abandonment of well or producing formation Dry hole

If a producing well is abandoned, date of last production _____ 19____
Was permission obtained from the Conservation Division or its agents before plugging was commenced? Yes

Name of Conservation Agent who supervised plugging of this well Fred Hampel
Producing formation _____ Depth to top _____ Bottom _____ Total Depth of Well 4790 Feet
Show depth and thickness of all water, oil and gas formations.

OIL, GAS OR WATER RECORDS

CASING RECORD

FORMATION	CONTENT	FROM	TO	SIZE	PUT IN	PULLED OUT
				8 5/8	221	None

Describe in detail the manner in which the well was plugged, indicating where the mud fluid was placed and the method or methods used in introducing it into the hole. If cement or other plugs were used, state the character of same and depth placed, from _____ feet to _____ feet for each plug set.

Heavy mud to 180'. Set plug. Cemented with
20 sacks cement. Heavy mud to 37'. Set Plug.
Cemented with 10 sacks cement to bottom of
cellar. Plugged rat hole with 2 sacks cement.

RECEIVED
STATE CORPORATION COMMISSION
MAY 24 1963
5-24-63
CONSERVATION DIVISION
Wichita, Kansas


(If additional description is necessary, use BACK of this sheet)
Name of Plugging Contractor PICKRELL DRILLING COMPANY
Address 705 4th NATL BANK BLDG, WICHITA 2, KANSAS

STATE OF KANSAS, COUNTY OF SEDGWICK, ss.
C. W. SEBITS (~~OWNER OR OPERATOR~~) of the above-described well, being first duly sworn on oath, says: That I have knowledge of the facts, statements, and matters herein contained and the log of the above-described well as filed and that the same are true and correct. So help me God.
(Signature) C. W. SEBITS
705 4th NATL BANK BLDG, WICHITA 2, KANSAS
(Address)

Subscribed AND SWORN to before me this 21st day of May, 1963

My commission expires June 21, 1966

Maxine Blackman
Maxine Blackman
Notary Public.

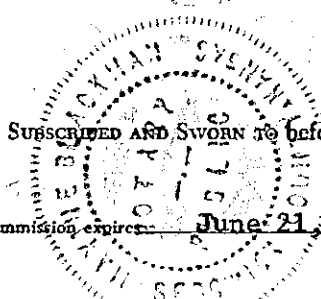

ROTARY DRILLING LOG

COMPANY: **PICKRELL DRILLING COMPANY & BRADLEY BROTHERS** Rotary Drilling Commenced 5-1-63
 705 4th Natl Bank Bldg.
 Wichita 2, Kansas Rotary Drilling Completed 5-15-63

LOCATION: Alford No. 1
 C NW SE Sec. 35-31S-8W
 Harper County, Kansas

CONTRACTOR: **PICKRELL DRILLING COMPANY**
 Wichita, Kansas

CASING RECORD: (6 joints) 8 5/8" Surface Casing set at 221', cemented with 160 sacks cement. Circulated. Completed 7:00 A.M. 5-2-63. No oil string run, D&A.

LOG

(Figures indicate bottom of formation — measurements from top of rotary bushing.)

220	Red Rock	<u>C. F. S.</u>
1020	Red Rock & Shale	3595
1390	Shale & Shells	3600
1655	Lime & Shale	3890
1950	Lime	4350
3600	Lime & Shale	4366
3710	Sand - Lime & Shale	4374
3917	Lime & Shale	4383
4170	Lime	4695
4358	Lime & Shale	4715
4536	Mississippian	4740
4580	Lime	4765
4610	Mississippian	4775
4680	Kinderhook	4790
4710	Shale & Lime	
4755	Viola	
4776	Simpson SAND	
4790	RTD	
		<u>Slope Tests</u>
		3584
		4239
		4618

RECEIVED
 STATE CORPORATION COMMISSION

MAY 24 1963
 5-24-63
 CONSERVATION DIVISION
 Wichita, Kansas

The undersigned, C. W. SEBITS, Attorney-in-Fact for PICKRELL DRILLING COMPANY, hereby certifies in behalf of said Company, that the above is a true and correct log of the formation encountered in drilling the above well as reflected by the Daily Drilling Reports.

PICKRELL DRILLING COMPANY
 By C. W. SEBITS Attorney-in-Fact

STATE OF KANSAS }
 COUNTY OF SEDGWICK } ss.:

On this 21st day of May, 19 63, before me the undersigned, a Notary Public, in and for the County and State aforesaid, personally appeared C. W. SEBITS, to me known to be the identical person who subscribed the name of PICKRELL DRILLING COMPANY to the foregoing instrument as its Attorney-in-Fact and acknowledged to me that he executed the same as his free and voluntary act and deed, and as the free and voluntary act and deed of such company, for the uses and purposes therein set forth.

Given under my hand and seal of office the day and year last above written.

My commission expires: June 21, 1966

Maxine Blackman
 Maxine Blackman Notary Public