


STATE OF KANSAS
STATE CORPORATION COMMISSION

Form CP-4

Give All Information Completely
Make Required Affidavit
Mail or Deliver Report to:
Conservation Division
State Corporation Commission
212 No. Market
Wichita, Kansas

WELL PLUGGING RECORD

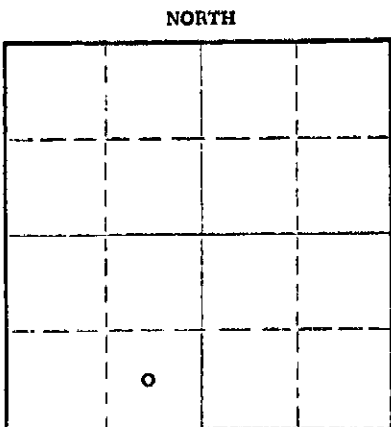

Harper County, Sec. 36 Twp. 31S Rgo. 8W (E) (W)
Location as "NE/CNW/SW" or footage from lines C SE SW
Lease Owner Landes Exploration Co. and Sentinel Resources Corp.
Lease Name Wilson Well No. 1
Office Address P. O. Box 867, Magnolia, Arkansas 71753
Character of Well (completed as Oil, Gas or Dry Hole) Dry Hole
Date well completed October 14 19 69
Application for plugging filed October 14 19 69
Application for plugging approved October 14 19 69
Plugging commenced October 14 19 69
Plugging completed October 14 19 69
Reason for abandonment of well or producing formation Dry Hole

If a producing well is abandoned, date of last production 19
Was permission obtained from the Conservation Division or its agents before plugging was commenced? Yes

Name of Conservation Agent who supervised plugging of this well R. J. Warren
Producing formation Depth to top Bottom Total Depth of Well 4794 Feet
Show depth and thickness of all water, oil and gas formations.

OIL, GAS OR WATER RECORDS

CASING RECORD

FORMATION	CONTENT	FROM	TO	SIZE	PUT IN	PULLED OUT
		0	240'	8 5/8"	240'	None

Describe in detail the manner in which the well was plugged, indicating where the mud fluid was placed and the method or methods used in introducing it into the hole. If cement or other plugs were used, state the character of same and depth placed, from feet to feet for each plug set.

Plug: 240'/25 sacks cement
40'/10 sacks cement

RECEIVED
STATE CORPORATION COMMISSION
10-21-69
OCT 21 1969
CONSERVATION DIVISION
Wichita, Kansas

(If additional description is necessary, use BACK of this sheet)
Name of Plugging Contractor Hellar Drilling Company, Inc.
Address 339 Union Center Bldg., Wichita, Kansas 67202


STATE OF Kansas, COUNTY OF Sedgwick, ss.

D. L. Hellar, President of Hellar Drig. Co. Inc. (employee of owner) or (owner or operator) of the above-described well, being first duly sworn on oath, says: That I have knowledge of the facts, statements, and matters herein contained and the log of the above-described well as filed and that the same are true and correct. So help me God.

(Signature) D. L. Hellar, President

339 Union Center Bldg., Wichita, Kansas 67202
(Address)

SUBSCRIBED AND SWORN to before me this 20th day of October, 19 69

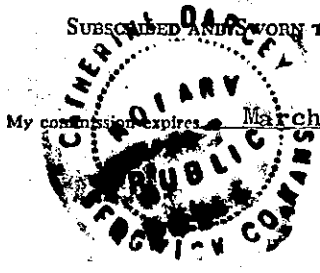

Catherine Darcey
Catherine Darcey - Notary Public.

DRILLER'S LOG

COMPANY: Landes Exploration Co. and Sentinel Resources Corp.
 P. O. Box 867, Magnolia, Arkansas 71753

CONTRACTOR: Hellar Drilling Company, Inc., Wichita, Kansas 67202

LEASE: #1 Wilson

LOCATION: C SE SW 36-31S-8W, Harper County, Kansas

COMMENCED: September 30, 1969

COMPLETED: October 14, 1969

CASING: Set 8 5/8" Surface Casing @ 240'/175 sacks cement

0-239	Shale and Red Bed
239-493	Red Beds
493-1245	Salt Section & Lime
1245-1661	Shale & Ft. Riley
1661-1989	Lime & Shale
1989-2080	Shale & Lime w/Chalk
2080-3428	Lime & Shale
3428-3748	Lime & Shale Sand
3748-3893	Lime & Shale
3893-3933	Lime & (L.K.C.)
3933-4025	Lime
4025-4387	Lime & Shale
4387-4573	Miss. Lime
4573-4780	Lime & Shale
4780-4785	Simpson Dolomite
4785-4794	Simpson Sand
4794-	Rotary Total Depth

RECEIVED
 STATE CORPORATION COMMISSION
 OCT 21 1969
 CONSERVATION DIVISION
 Wichita, Kansas

D & A

STATE OF KANSAS)
) SS
 COUNTY OF SEDGWICK)

I. D. L. Hellar, do hereby certify that the above and foregoing is a true and correct copy of the log of the #1 Wilson, located in C SE SW 36-31S-8W, Harper County, Kansas, as reflected by the files of the Hellar Drilling Company, Inc.

HELLAR DRILLING COMPANY, INC.

By *D. L. Hellar*
 President - D. L. Hellar

Subscribed and sworn to before me, a Notary Public, in and for Sedgwick County, Kansas, this 20th day of October, 1969.

Catherine Darcey
 Notary Public - Catherine Darcey



My Commission Expires: March 25, 1972.