

15-077-10081-0000

STATE OF KANSAS  
STATE CORPORATION COMMISSION


WELL PLUGGING RECORD

Give All Information Completely  
Make Required Affidavit  
Mail or Deliver Report to:  
Conservation Division  
State Corporation Commission  
211 No. Broadway  
Wichita, Kansas

Harper County. Sec. 21 Twp. 31 Rge. 8 (W)

Location as "NE/CNW/SW" or footage from lines NW SE NW  
Lease Owner Stanolind Oil and Gas Company  
Lease Name J. C. Burgess "B" Well No. 1  
Office Address Box 1654, Oklahoma City, Oklahoma  
Character of Well (completed as Oil, Gas or Dry Hole) Oil  
Date well completed 7-14- 19 55  
Application for plugging filed 4-16- 19 56  
Application for plugging approved 4-17- 19 56  
Plugging commenced 5-11- 19 56  
Plugging completed 5-15- 19 56  
Reason for abandonment of well or producing formation Economically Depleted

NORTH

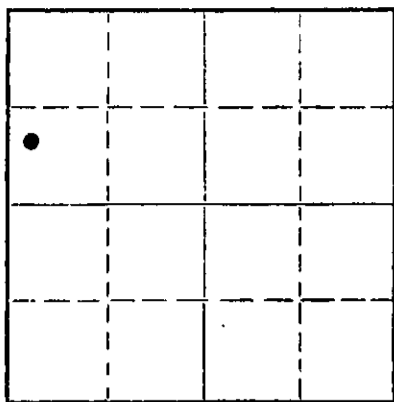

Locate well correctly on above  
Section Plat

If a producing well is abandoned, date of last production February 19 56

Was permission obtained from the Conservation Division or its agents before plugging was commenced? Yes

Name of Conservation Agent who supervised plugging of this well M. A. Rives  
Producing formation Mississippi Depth to top 4388 Bottom 4403 Total Depth of Well 4425 Feet

Show depth and thickness of all water, oil and gas formations.

OIL, GAS OR WATER RECORDS

CASING RECORD

FORMATION	CONTENT	FROM	TO	SIZE	PUT IN	PULLED OUT
Mississippi	Water	4388	4403	8-5/8	206	None
				5-1/2	4443	3117

Describe in detail the manner in which the well was plugged, indicating where the mud fluid was placed and the method or methods used in introducing it into the hole. If cement or other plugs were used, state the character of same and depth placed, from \_\_\_\_\_ feet to \_\_\_\_\_ feet for each plug set.

Dumped Sand 4403-4380  
 5 Sx Cement 4380-4351  
 Hvy Mud 4351- 200  
 Crushed Rock 200- 190  
 20 Sx Cement 190- 130  
 Hvy Mud 130- 35  
 Crushed Rock 35- 30  
 10 Sx Cement 30- To Base of Cellar

(If additional description is necessary, use BACK of this sheet)

Name of Plugging Contractor West Supply Company  
Address Chase, Kansas

STATE OF KANSAS, COUNTY OF BARTON, ss.  
I, G. A. Reynolds (employee of owner) or (owner or operator) of the above-described well, being first duly sworn on oath, says: That I have knowledge of the facts, statements, and matters herein contained and the log of the above-described well as filed and that the same are true and correct. So help me God.

(Signature) [Signature]  
Box 7, Ellinwood, Kansas  
(Address)

SUBSCRIBED AND SWORN TO before me this 16th day of May, 19 56

My commission expires November 12, 1958

[Signature]  
Notary Public.

PLUGGING  
FILE SEC 21 T 31 R 8W  
BOOK PAGE 54 LINE 9



FORMATION RECORD

DESCRIBE EACH FORMATION DRILLED. INDICATE THICKNESS, CONTENT AND WHETHER DRY, OR OIL, GAS, OR WATER BEARING.

FORMATION	TOP	BOTTOM	FORMATION	TOP	BOTTOM
Clay, Sand	0	65			
Red Bed, Shells	65	170			
Red Bed	170	220			
Red Rock, Shale	220	710			
Shale	710	1107			
Lime, Shale	1107	1410			
Sandy Lime	1410	2455			
Lime, Shale	2455	2745			
Lime	2745	2855			
Lime, Shale	2855	3035			
Lime	3035	3570			
Lime, Shale	3570	3633			
Top Loup	3633				
Lime	3633	3805			
Lime, Shale	3805	3975			
Lime, Chert	3975	3983			
Lime, Shale	3983	4240			
Broken Lime	4240	4285			
Lime, Shale	4285	4388			
Top Mississippi	4388				
Cherty Lime, Oil, Gas	4388	4403			
Cherty Lime, Salt Water	4403	4425			
Non Schlumberger Electric Log to 740.					
Total Depth					
By Schlumberger		4425-1/2			
By Rotary Drill		4425			
Well Completed - 7-14-55					
Mississippi Formation					
Plug Back Depth		4403			
Producing Interval	4389	4390			