


STATE OF KANSAS
STATE CORPORATION COMMISSION

WELL PLUGGING RECORD

Give All Information Completely
Make Required Affidavit
Mail or Deliver Report to
Conservation Division
State Corporation Comm.
245 North Water
Wichita, KS 67202

Harper County, Sec. 9 Twp. 31S Rge. 8 E/W
Location as "NE/CNW $\frac{1}{4}$ SW $\frac{1}{4}$ " or footage from lines
C W/2 SE NW

Lease Owner Petroleum, Inc.
Lease Name Warren "F" Well No. 1
Office Address 300 W. Douglas, Suite 800, Wichita, Kansas 67202
Character of Well (Completed as Oil, Gas or Dry Hole)
Dry Hole

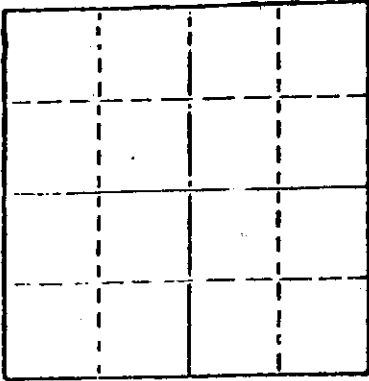

Locate well correctly on above
Section Plat

Date Well completed September 18 1980
Application for plugging filed September 18 1980
Application for plugging approved September 18 1980
Plugging commenced September 18 1980
Plugging completed September 18 1980
Reason for abandonment of well or producing formation

If a producing well is abandoned, date of last production 19

Was permission obtained from the Conservation Division or its agents before plugging was commenced? Yes

Name of Conservation Agent who supervised plugging of this well Wm. T. Owen, Pratt, Kansas
Producing formation Depth to top Bottom Total Depth of Well 4480'
Show depth and thickness of all water, oil and gas formations.

OIL, GAS OR WATER RECORDS

CASING RECORD

FORMATION	CONTENT	FROM	TO	SIZE	PUT IN	PULLED OUT
				8-5/8"	210'	None

Describe in detail the manner in which the well was plugged, indicating where the mud fluid was placed and the method or methods used in introducing it into the hold. If cement or other plugs were used, state the character of same and depth placed, from feet to feet for each plug set.

Pumped 40 sacks cement through drill pipe to 210 feet. Pushed plug and sack hulls to 40 feet with 10 sacks cement. Plugged rat hole with 10 sacks cement.

RECEIVED
STATE CORPORATION COMMISSION

10-3-80
CONSERVATION DIVISION
Wichita, Kansas

(If additional description is necessary, use BACK of this report)

Name of Plugging Contractor Graves Drilling Co., Inc.

STATE OF KANSAS COUNTY OF SEDGWICK
Betty Brandt (employee of owner) or (owner or operator)
of the above-described well, being first duly sworn on oath, says: That I have knowledge of the facts, statements, and matters herein contained and the log of the above-described well as filed and that the same are true and correct. So help me God.

(Signature) Betty Brandt
910 Union Center, Wichita, Kansas 67202
(Address)

SUBSCRIBED AND SWORN TO before me this 2nd day of October, 19 80

Rebecca L. Matthews
Notary Public.

My commission expires May 17, 1983

ROTARY DRILLERS' LOG

OPERATOR: Petroleum, Inc. DRILLING COMMENCED: September 8, 1980
 300 West Douglas, Suite 800
 Wichita, Kansas 67202

CONTRACTOR: Graves Drilling Co., Inc. DRILLING COMPLETED: September 18, 1980
 910 Union Center
 Wichita, Kansas 67202

CASING RECORD: 5 Jts. 210' of new 8-5/8" LOCATION: Warren "F" No. 1
 cemented with 220 sacks. C W/2 SE NW
 Section 9-31S-8W
 Harper County, Kansas

0 - 80	Sod, clay & sand
80 - 120	Sand
120 - 210	Red bed
210 - 1553	Red bed & shale
1553 - 1992	Shale & lime
1992 - 2453	Lime & shale
2453 - 3251	Shale & lime
3251 - 3609	Lime & shale
3609 - 3749	Shale & lime
3749 - 4010	Lime & shale
4010 - 4112	Shale & lime
4112 - 4288	Lime & shale
4288 - 4425	Shale & lime
4425 - 4480	Lime
4480	Rotary Total Depth

RECEIVED
 STATE CORPORATION COMMISSION
 OCT - 3 1980
 10-3-80
 CONSERVATION DIVISION
 Wichita, Kansas

I hereby certify the foregoing statements to be true and correct to the best of my knowledge.

Copy sent to:
 State Corporation Commission
 Kansas Geological Society
 Kansas Geological Survey

GRAVES DRILLING CO., INC.

By Betty Brandt
 Secretary-Treasurer

STATE OF KANSAS)
) ss:
 SEDGWICK COUNTY)

Subscribed and sworn to before me, a Notary Public, this 2nd day of October, 1980.

Rebecca L. Matthews
 Rebecca L. Matthews Notary Public

My commission expires: May 17, 1983.