

15-077-00029-0000


STATE OF KANSAS  
STATE CORPORATION COMMISSION

Give All Information Completely  
Make Required Affidavit  
Mail or Deliver Report to:  
Conservation Division  
State Corporation Commission  
211 No. Broadway  
Wichita, Kansas

WELL PLUGGING RECORD

Harper County, Sec. 22 Twp. 31S Rge. 8W (E) (W)

NORTH

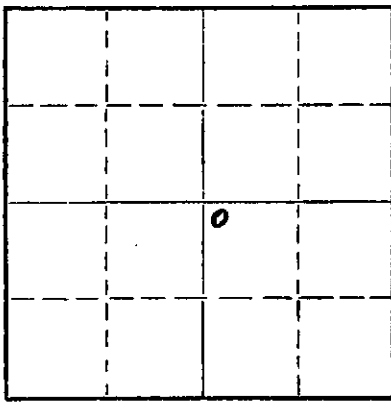

Locate well correctly on above  
Section Plat

Location as "NE/CNW&SW&" or footage from lines NW NW SE  
Lease Owner The Superior Oil Company  
Lease Name Williams Well No. 2-22 SWD  
Office Address Box 690, Chickasha, Oklahoma  
Character of Well (completed as Oil, Gas or Dry Hole) Salt Water Disposal Well  
Date well completed September 25, 19 55  
Application for plugging filed July 15, 19 58  
Application for plugging approved July 16, 19 58  
Plugging commenced July 17, 19 58  
Plugging completed July 18, 19 58  
Reason for abandonment of well or producing formation Abandonment of only  
producing well on lease.  
If a producing well is abandoned, date of last production \_\_\_\_\_ 19 \_\_\_\_  
Was permission obtained from the Conservation Division or its agents before plugging was com-  
menced? Yes

Name of Conservation Agent who supervised plugging of this well Mr. Fred Hampel  
Producing formation \_\_\_\_\_ Depth to top \_\_\_\_\_ Bottom \_\_\_\_\_ Total Depth of Well 1825 Feet  
Show depth and thickness of all water, oil and gas formations.

OIL, GAS OR WATER RECORDS

CASING RECORD

FORMATION	CONTENT	FROM	TO	SIZE	PUT IN	PULLED OUT
Fort Riley	Salt water	1550	1825	7"	1550'	None
				10-3/4"	305'	None

Describe in detail the manner in which the well was plugged, indicating where the mud fluid was placed and the method or methods used in introducing it into the hole. If cement or other plugs were used, state the character of same and depth placed, from \_\_\_\_\_ feet to \_\_\_\_\_ feet for each plug set.

Placed 50 sack cement plug at 1530 ft. Filled hole with heavy mud. Placed 35 ft. cement plug at top of 7" casing. Welded on steel cap.

RECEIVED  
JUL 23 1958  
7-23-58  
CONSERVATION DIVISION  
WICHITA, KANSAS

(If additional description is necessary, use BACK of this sheet)

Name of Plugging Contractor Pratt Well Service  
Address Pratt, Kansas

STATE OF Oklahoma, COUNTY OF Grady, ss.  
Wm. N. Mosley, District Engineer (employee of owner) or (owner or operator) of the above-described well, being first duly sworn on oath, says: That I have knowledge of the facts, statements, and matters herein contained and the log of the above-described well as filed and that the same are true and correct. So help me God.

(Signature) Wm. N. Mosley  
Box 690, Chickasha, Oklahoma  
(Address)

SUBSCRIBED AND SWORN to before me this 23rd day of July, 19 58

My commission expires September 15, 1960

M. F. Fiegel  
Notary Public.

PLUGGING  
FILE SEC 22 T 31 R 8W  
BOOK PAGE 115 LINE 25

THE SUPERIOR OIL COMPANYWilliams #2-22 NW-NW-SE Section 22-31S-8W, Harper County, Kansas

Cemented 10-3/4" Casing at 305 ft. with 250 sacks Pozmix cement.

Drillers log:

Sand & red beds	0	318'
Lime & shale	318	920
Salt & chalk	920	1540
Dolomite & shale	1540	2000
Dolomite & anhydrite	2000	2400
Lime & shale	2400	2600
Lime	2600	2770
Lime & shale	2770	2960
Lime & dolomite	2960	3240
Lime & shale	3240	3630
Lime	3630	3780
Shale	3780	3880
Lime & shale	3880	4390
Chert	4390	4460
T.D.	4460.	

RECEIVED  
STATE CORPORATION COMMISSION

JUL 16 1958  
7-16-58  
CONSERVATION DIVISION  
Wichita, Kansas

PLUGGING  
FILE SEC 22 T 31 R 8W  
BOOK PAGE 115 LINE 25