


STATE OF KANSAS
STATE CORPORATION COMMISSION

WELL PLUGGING RECORD

Give All information Completely
Make Required Affidavit
Mail or Deliver Report to:
Conservation Division
State Corporation Commission
800 Bittling Building
Wichita, Kansas

Rice County. Sec. 27 Twp. 20 Rge. (E) 6 (W)
Location as "NE/CNW $\frac{1}{4}$ SW $\frac{1}{4}$ " or footage from lines SE SE SW
Lease Owner Donald T. Ingling et al
Lease Name Wernet Well No. 1
Office Address 708 Fourth National Bldg, Wichita, 2, Kas.
Character of Well (completed as Oil, Gas or Dry Hole) dry hole
Date well completed January 31, 1950
Application for plugging filed January 31, 1950
Application for plugging approved January 31, 1950
Plugging commenced January 31, 1950
Plugging completed January 31, 1950
Reason for abandonment of well or producing formation dry hole

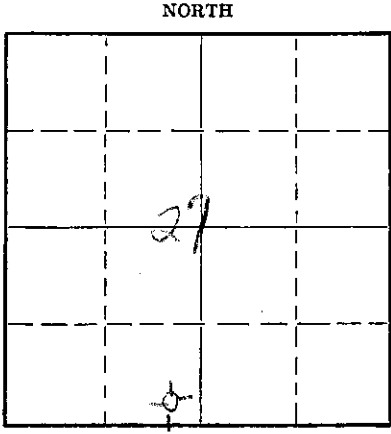

Locate well correctly on above Section Plat

If a producing well is abandoned, date of last production none 19
Was permission obtained from the Conservation Division or its agents before plugging was commenced? YES

Name of Conservation Agent who supervised plugging of this well Ruel Durkee
Producing formation Depth to top Bottom Total Depth of Well 3433 Feet
Show depth and thickness of all water, oil and gas formations.

OIL, GAS OR WATER RECORDS CASING RECORD

Formation	Content	From	To	Size	Put In	Puled Out
				8 5/8"	98'	none

Describe in detail the manner in which the well was plugged, indicating where the mud fluid was placed and the method or methods used in introducing it into the hole. If cement or other plugs were used, state the character of same and depth placed, from feet to feet for each plug set.

Laid down one-half drill pipe - circulated heavy mud then laid down balance drill pipe - circulated mud - wooden plug at 150 feet then 20 sacks cement - then mud - wooden plug at 30 feet then five sacks sement to top.

FEB 27 1950 02-02-50


(If additional description is necessary, use BACK of this sheet)
Correspondence regarding this well should be addressed to Donald T. Ingling
Address 708 Fourth National Building, Wichita, 2, Kansas

STATE OF Kansas, COUNTY OF Sedgwick, ss.
M. E. Black (employee of owner) or (owner or operator) of the above-described well,
being first duly sworn on oath, says: That I have knowledge of the facts, statements, and matters herein contained and the log of the above-described well as filed and that the same are true and correct. So help me God.

(Signature) M. E. Black
708 Fourth Nat'l Bldg. Wichita, Kas.
(Address)

SUBSCRIBED AND SWORN to before me this 1st day of February, 1950.

My commission expires October 22, 1953
Mary Hanson Notary Public.

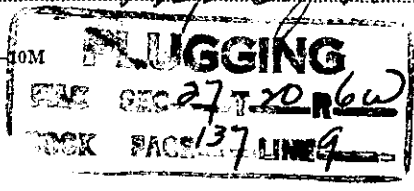

WELL LOG - WERNET NO. 1

Donald T. Ingling et al, Lease Owner

Sec. 27, Twp. 20, Rge. 6W

Donald T. Ingling, Operator

Location: C SE SE SW

Total Depth: 3433'

County: Rice Kansas

Commenced: January 12, 1950

Elevation: 1603 D.F.

Completed: January 31, 1950

Production: Dry

Casing: 98' 8 5/8"

Figures below indicate bottom of formation:

98	Lime	2733	Sandy lime
120	Red rock and Shale	2785	Lime
400	Red rock and Shells	2813	Lime and Shale
560	Shale & Shells	3135	Lime
810	Salt and Shale	3330	Lime and Shale
880	Shale	3374	Shale
1040	Lime and Shale	3375	Conglomerate
1280	Lime	3426	Chat
2345	Lime and Shale	3433	Mississippi Lime
2635	Lime	3433	Total Depth

I hereby certify that this is a true and correct log of the above mentioned well.

DONALD T. INGLING

M. E. Black

STATE OF KANSAS |

SS.

SEDGWICK COUNTY |

Subscribed and sworn to before me, a Notary Public in said County and State this 1st day of February, 1950.

Mary Hanna
Notary Public

My Commission Expires: October 22, 1953

