


STATE OF KANSAS
STATE CORPORATION COMMISSION

Form CP-4

WELL PLUGGING RECORD

Give All Information Completely
Make Required Affidavit
Mail or Deliver Report to:
Conservation Division
State Corporation Commission
P. O. Box 17027
Wichita, Kansas 67217

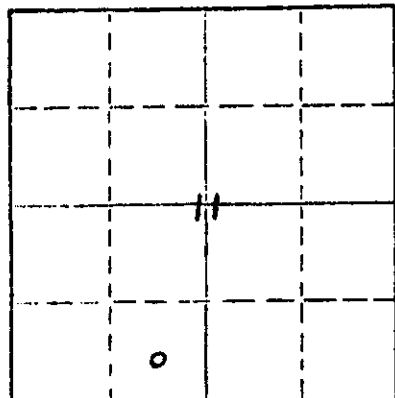

Locate well correctly on above
Section Plat

Seward County, Sec. 11 Twp. 34S Rge. (X) 31 (W)

Location as "NE/CNWSW" or footage from lines. C SE/4 SW/4

Lease Owner Venus Oil Company

Lease Name Iris Well No. 1

Office Address 1200 N.B.C. Building, San Antonio, Texas 78205

Character of Well (completed as Oil, Gas or Dry Hole) Gas

Date well completed September 11, 19 62

Application for plugging filed February 2, 19 72

Application for plugging approved February 11, 19 72

Plugging commenced March 14, 19 72

Plugging completed March 16, 19 72

Reason for abandonment of well or producing formation depleted and watered out

If a producing well is abandoned, date of last production August 19 71

Was permission obtained from the Conservation Division or its agents before plugging was commenced? Yes

Name of Conservation Agent who supervised plugging of this well E. Eves, Box "F", Sublette, Kansas

Producing formation Council Grove Depth to top 3024 Bottom 3034 Total Depth of Well 6030 Feet

Show depth and thickness of all water, oil and gas formations. P.B.T.D: 4993'

OIL, GAS OR WATER RECORDS

CASING RECORD

FORMATION	CONTENT	FROM	TO	SIZE	PUT IN	PULLED OUT
Council Grove	Gas	3024	3034	8 5/8 5 1/2"	1555' 6030'	none 2483'

Describe in detail the manner in which the well was plugged, indicating where the mud fluid was placed and the method or methods used in introducing it into the hole. If cement or other plugs were used, state the character of same and depth placed, from _____ feet to _____ feet to _____ feet for each plug set.

Mud from 4993' to 3050'

Hulls and cement and plug from 3050' to 2800' (25 sacks)

Mud from 2800' to 1580'

Cement from 1580' to 1480' (35 sacks)

Mud from 1480' to 45'

Cement from 45' to 0' (15 sacks)

welded plate on surface casing (cut off 3' below ground level)

RECEIVED
STATE CORPORATION COMMISSION
APR 3 - 1972
CONSERVATION DIVISION
Wichita, Kansas

Name of Plugging Contractor Sargent's Casing Pulling Service.
Address P.O. Box 506, Liberal, Kansas 67901

STATE OF Texas COUNTY OF Bexar, ss.
Dale P. Jewett (employee of owner) ~~NOTARY PUBLIC~~ of the above-described

well, being first duly sworn on oath, says: That I have knowledge of the facts, statements, and matters herein contained and the log of the above-described well as filed and that the same are true and correct. So help me God.

(Signature) Dale P. Jewett
R.F.D. #4, Hutchinson, Kansas 67501
(Address)

SUBSCRIBED AND SWORN TO before me this 28th day of March, 1972

My commission expires June 1, 1973

Richard Richter
Notary Public
In and For Bexar County, Kansas

COPY


WELL LOG BUREAU--KANSAS GEOLOGICAL SOCIETY
508 East Murdock, Wichita, Kansas

Company- **J. M. HUBER CORPORATION**
Farm- **Iris** No. **1**

SEC. 11 T. 34 R. 31W
C SE SW

Total Depth. **6030'**
Comm. **7-10-62** Comp. **8-4-62**
Shot or Treated.
Contractor. **McClellan Drilling**
Issued. **2-16-63**

County **Seward**
KANSAS

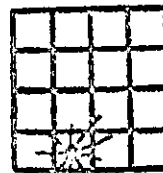

CASING:
8 5/8" 1555' cem w/900 sx.
5 1/2" 6031' cem w/525 sx.

Elevation. 2628'

Production. **8,800,000 CPG**

Figures Indicate Bottom of Formations.

surface clay	300
surface clay & sand	490
red bed & gyp	970
sand	985
red bed & gyp	1170
red bed, gyp & sand	1374
red bed & gyp	1556
shale & shells	1610
lime & shale	2907
lime	2935
lime & shale	3280
lime	3365
lime w/shale streaks	3495
lime & shale	3670
shale	3860
lime & shale	4422
lime	4485
lime & shale	4533
lime & shale	4967
lime	5285
lime & shale	5438
lime	5517
lime & shale	5751
lime	6030 RTD
Total Depth	
TOPS: SAMPLE	
Wreford	2835
Council Grove	2976
TOPS: LOG	
Base Heabner	4232
Toronto	4237
Lansing	4374
Drum	4662
Hodges	4852
Marmaton	5034
Cherokee	5195
Atoka	5501
Ngrow	5542
Chester	5676
Chester Sand	5760
St. Genoyeva	5790
St. Louis	5976

RECEIVED
STATE CORPORATION COMMISSION
FEB 9 1972
CONSERVATION DIVISION
Wichita, Kansas