


STATE OF KANSAS
STATE CORPORATION COMMISSION

WELL PLUGGING RECORD

Give All Information Completely
Make Required Affidavit
Mail or Deliver Report to
Conservation Division
State Corporation Comm.
245 North Water
Wichita, KS 67202

Ellis County, Sec. 6 Twp. 11S Rge. 16W XE/W
Location as "NE/CNW $\frac{1}{4}$ SW $\frac{1}{4}$ " or footage from lines
S/2 SE/4 SE/4

Lease Owner Robert R. Price Operating, Inc.
Lease Name Chesney Well No. #1
Office Address Box 45442, Tulsa, Oklahoma 74147
Character of Well (Completed as Oil, Gas or Dry Hole)

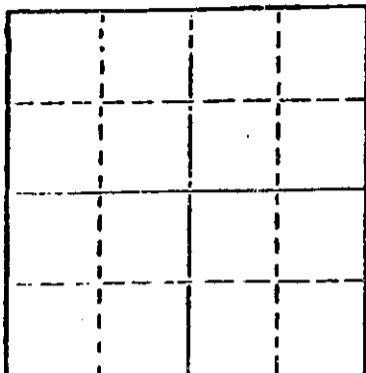

Locate well correctly on above
Section Plot

Dry Hole
Date Well completed 5-28 19 83
Application for plugging filed 5-28 19 83
Application for plugging approved 5-28 19 83
Plugging commenced 5-28 19 83
Plugging completed 5-28 19 83

Reason for abandonment of well or producing formation
Dry Hole

If a producing well is abandoned, date of last production
19.

Was permission obtained from the Conservation Division or
its agents before plugging was commenced? yes

Name of Conservation Agent who supervised plugging of this well Ed Schumacher
Producing formation Depth to top Bottom Total Depth of Well

Show depth and thickness of all water, oil and gas formations.

OIL, GAS OR WATER RECORDS

CASING RECORD

FORMATION	CONTENT	FROM	TO	SIZE	PUT IN	PULLED OUT
				8-5/8"	209'	-0-

Describe in detail the manner in which the well was plugged, indicating where the mud fluid
was placed and the method or methods used in introducing it into the hold. If cement or other
plugs were used, state the character of same and depth placed, from _____ feet to
_____ feet for each plug set.

Mud laden fluid to 1125'
20 sx cement @ 1120'
80 sx cement @ 556'
40 sx cement @ 240'
10 sx cement @ 40'
10 sx cement in Rat Hole

(If additional description is necessary, use BACK of this sheet)

Name of Plugging Contractor Ranger Drilling Company, Inc.
P.O.Box 856, Hays, Kansas 67601

STATE OF KANSAS COUNTY OF ELLIS, ss.
Jay C. Boyer (employee of owner) or (owner or operator)
of the above-described well, being first duly sworn on oath, says: That I have knowledge of
the facts, statements, and matters herein contained and the log of the above-described well
as filed and that the same are true and correct. So help me God.

(Signature) Jay C. Boyer
P.O. Box 856, Hays, Kansas 67601
(Address)

SUBSCRIBED AND SWORN TO before me this 6th day of June, 19 83

Mary L. Kehn
Notary Public.

My commission expires 8-6-85

MARY L. KEHN
NOTARY PUBLIC
OF KANSAS

RECEIVED
STATE CORPORATION COMMISSION

JUN 15 1983

CONSERVATION DIVISION
Wichita, Kansas