


15-1165-19049-0000

STATE OF KANSAS  
STATE CORPORATION COMMISSION

Give All Information Completely  
Make Required Affidavit  
Mail or Deliver Report to:  
Conservation Division  
State Corporation Commission  
211 No. Broadway  
Wichita, Kansas

WELL PLUGGING RECORD

NORTH

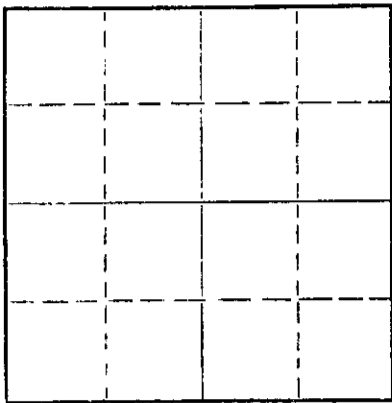

Locate well correctly on above  
Section Plat

Rush County. Sec. 27 Twp. 17S Rge. 17W (W) W  
Location as "NE/CNW/SW" or footage from lines C W/2 W/2 NE/4  
Lease Owner Frontier Oil Company  
Lease Name Neuhauser Well No. 1  
Office Address 580 Fourth Nat'l. Bank Bldg., Wichita, Ks.  
Character of Well (completed as Oil, Gas or Dry Hole) D & A  
Date well completed July 21 1962  
Application for plugging filed July 21 1962  
Application for plugging approved July 21 1962  
Plugging commenced July 21 1962  
Plugging completed July 21 1962  
Reason for abandonment of well or producing formation D & A

If a producing well is abandoned, date of last production \_\_\_\_\_ 19\_\_\_\_  
Was permission obtained from the Conservation Division or its agents before plugging was com-  
menced? Yes

Name of Conservation Agent who supervised plugging of this well Eldon Petty  
Producing formation \_\_\_\_\_ Depth to top \_\_\_\_\_ Bottom \_\_\_\_\_ Total Depth of Well 3560' Feet  
Show depth and thickness of all water, oil and gas formations.

OIL, GAS OR WATER RECORDS

CASING RECORD

FORMATION	CONTENT	FROM	TO	SIZE	PUT IN	PULLED OUT
				8 5/8"	218'	-0-

Describe in detail the manner in which the well was plugged, indicating where the mud fluid was placed and the method or methods used in introducing it into the hole. If cement or other plugs were used, state the character of same and depth placed, from \_\_\_\_\_ feet to \_\_\_\_\_ feet for each plug set.

Plugged with 125 sx cement thru casing.

RECEIVED  
STATE CORPORATION COMMISSION  
7-24-62  
JUL 24 1962  
CONSERVATION DIVISION  
Wichita, Kansas

(If additional description is necessary, use BACK of this sheet)  
Name of Plugging Contractor Red Tiger Drilling  
Address Box 173--Russell, Kansas

STATE OF KANSAS COUNTY OF SEDGWICK, ss.  
Maxine Head (employee of owner) of the above-described well, being first duly sworn on oath, says: That I have knowledge of the facts, statements, and matters herein contained and the log of the above-described well as filed and that the same are true and correct. So help me God.

(Signature) Maxine Head  
580 Fourth Nat'l Bank Bldg., Wichita, Kans.  
(Address)

SUBSCRIBED AND SWORN TO before me this 23rd day of July, 19 62

Jean Kollar  
Notary Public.

My commission expires 5-22-66

INVOICED

DATE 7/24/62  
INV. NO. 5416-W

DRILLERS LOG

Neuhauser No. 1

CASING RECORD: 8 5/8" @ 218 w/135 sx cement  
COMPANY: Frontier Oil Company  
CONTRACTOR: Red Tiger Drilling Co.  
COMMENCED: July 12, 1962  
COMPLETED: July 21, 1962  
DESCRIPTION: CW/2 W/2 NE/4 27-17S-17W Rush Co., Kansas  
ELEVATION: 2028 DF 2031 RB  
TOTAL DEPTH: 3560'

<u>FORMATION</u>	<u>FROM</u>	<u>TO</u>	<u>REMARKS</u>
Clay Rock & Shale	0	219	
Shale & Shells	219	522	
Sand	522	770	
Shale & Sand String	770	1107	
Anhydrite	1107	1146	
Shale & Shells	1146	1515	
Lime & Shale	1515	2170	
Lime & Shale & Pyrite	2170	2245	
Lime & Shale	2245	2455	
Shale w/Sandy Lime	2455	2640	
Shale & Shells	2640	2796	
Shale w/Lime	2796	3340	
Lime	3340	3539	
Lime & Shale	3539	3560	

RECEIVED  
STATE CORPORATION COMMISSION  
7-24-62  
JUL 24 1962  
CONSERVATION DIVISION  
Wichita, Kansas

I certify that this is a true and correct copy of the above log to the best of my knowledge.

FRONTIER OIL COMPANY

Maxine Head  
Maxine Head

Subscribed and sworn to before me this 23rd day of July, 1962.

Jean Hollar  
Notary Public

My Commission Expires:

5-22-66