


STATE OF KANSAS
STATE CORPORATION COMMISSION

WELL PLUGGING RECORD

Give All Information Completely
Make Required Affidavit
Mail or Deliver Report to:
Conservation Division
State Corporation Commission
800 Biting Building
Wichita, Kansas

Harper County. Sec. 23 Twp. 31 Rge. 8 (E) W (W)
Location as "NE/CNW/SW" or footage from lines NE SW SW
Lease Owner Trans Era Petroleum, Inc.
Lease Name Thompson Well No. 1
Office Address Russell, Kansas
Character of Well (completed as Oil, Gas or Dry Hole) Dry Hole
Date well completed 12/3/54 1954
Application for plugging filed 12/2/54 1954
Application for plugging approved 12/2/54 1954
Plugging commenced 12/3/54 1954
Plugging completed 12/3/54 1954
Reason for abandonment of well or producing formation Dry Hole

NORTH

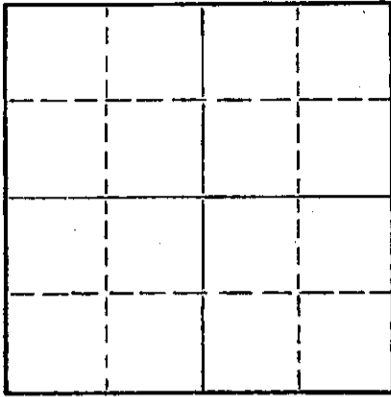

Locate well correctly on above
Section Plat

If a producing well is abandoned, date of last production _____ 19____
Was permission obtained from the Conservation Division or its agents before plugging was commenced? Yes

Name of Conservation Agent who supervised plugging of this well Ruel Durkee
Producing formation _____ Depth to top _____ Bottom _____ Total Depth of Well 4815 Feet
Show depth and thickness of all water, oil and gas formations.

OIL, GAS OR WATER RECORDS

CASING RECORD

FORMATION	CONTENT	FROM	TO	SIZE	PUT IN	PULLED OUT
				8 5/8"	205'	None

Describe in detail the manner in which the well was plugged, indicating where the mud fluid was placed and the method or methods used in introducing it into the hole. If cement or other plugs were used, state the character of same and depth placed, from _____ feet to _____ feet for each plug set.

PLUGGING RECORD

Lay down drill pipe. Filled hole with heavy mud to 200', bridged plug solid and cemented with 15 sacks of cement. Filled hole with mud to 25' set plug and cemented with 5 sacks of cement.

RECEIVED
STATE CORPORATION COMMISSION
DEC 11 1954
12-11-54
CONSERVATION DIVISION
Wichita, Kansas

(If additional description is necessary, use BACK of this sheet)

Name of Plugging Contractor Trans Era Petroleum, Inc.
Address Russell, Kansas

STATE OF KANSAS, COUNTY OF RUSSELL, ss.
H. R. Michaelis (employee of owner) or (owner or operator) of the above-described well, being first duly sworn on oath, says: That I have knowledge of the facts, statements, and matters herein contained and the log of the above-described well as filed and that the same are true and correct. So help me God.

(Signature) H. R. Michaelis
Russell, Kansas
(Address)

SUBSCRIBED AND SWORN to before me this 9th day of December, 1954

My commission expires 1-30-57
Margie Cooper Notary Public.

PLUGGING
FILE SEC 23 T 31 R W
BOOK PAGE 12 LINE 22

Trans Era Petroleum, Inc.
Thompson #1

NE SW SW 23-31-8
Harper County, Ks.

Total Depth: 4815'
Comm. 11/15/54
Comp. 12/3/54

Casing
8 5/8" Set @ 205'

Cement
175 sacks Atlas

FORMATION	DEPTH
Surface soil-clay	40
Red bed-sand	125
Red bed	173
Red bed-shale	390
Red bed	650
Shale	1015
Salt	1050
Shale	1250
Anhydrite	1470
Anhydrite-shale	1515
Shale-lime	1680
Lime	1795
Lime-shale	2125
Shale	2255
Lime-shale	3205
Lime	3295
Lime-shale	3438
Sand-shale	3474
Shale	3555
Shale-lime	3920
Lime	4160
Lime-shale	4257
Lime	4299
Lime-shale	4360
Mississippi Lime	4375
Lime	4645
Lime-shale	4715
Viola	4765
Shale-sand (Simpson)	4777
Simpson sand	4815'

STATE OF KANSAS)
RUSSELL COUNTY) ss

12-11-54

I hereby certify that the above information is true and correct to the best of my knowledge.

Caro Betty

Subscribed and sworn to before me this 9th day of December, 1954.

Margie Cooper
Notary Public

My commission expires: 1-30-57.

