


STATE OF KANSAS
STATE CORPORATION COMMISSION

WELL PLUGGING RECORD

Give All Information Completely
Make Required Affidavit
Mail or Deliver Report to
Conservation Division
State Corporation Comm.
245 North Water
Wichita, KS 67202

HARPER County, Sec. 27 Twp. 31 S Rge. 8 W E/W
Location as "NE/CNW $\frac{1}{2}$ /SW $\frac{1}{2}$ " or footage from lines
~~330 FTL 1650 FTL~~ S C NW NE NW NW

Lease Owner TEXAS OIL AND GAS CORPORATION
Lease Name MUIR Well No. C-1
Office Address 200 W Doulgas, Suite 300, Wichita, Ks.
Character of Well (Completed as Oil, Gas or Dry Hole) DRY

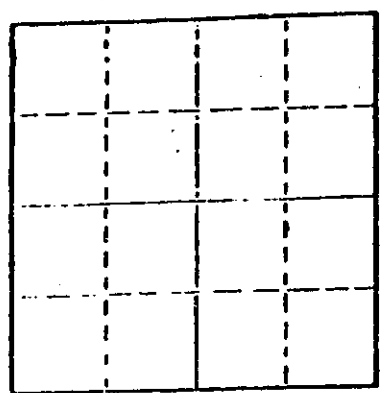

Date Well completed MAY 1979
Application for plugging filed 6-19 1979
Application for plugging approved 6-20 1979
Plugging commenced 6-20 1979
Plugging completed 6-27 1979
Reason for abandonment of well or producing formation DRY

If a producing well is abandoned, date of last production 19

Was permission obtained from the Conservation Division or its agents before plugging was commenced? YES

Name of Conservation Agent who supervised plugging of this well BILL OWENS
Producing formation _____ Depth to top _____ Bottom _____ Total Depth of Well 4568
Show depth and thickness of all water, oil and gas formations.

OIL, GAS OR WATER RECORDS

CASING RECORD

FORMATION	CONTENT	FROM	TO	SIZE	PUT IN	PULLED OUT
				8 5/8	234	NONE
				4 1/2	4507	3693 49

Describe in detail the manner in which the well was plugged, indicating where the mud fluid was placed and the method or methods used in introducing it into the hold. If cement or other plugs were used, state the character of same and depth placed, from _____ feet to _____ feet for each plug set.

SAND FROM 4474 to ~~4375~~ 4375. 4 Sacks cement from 4375 to ~~4340~~ 4340.
Wood bridge at 230. Rock to 220. 4 yards ready mix.

RECEIVED
STATE CORPORATION COMMISSION
10-5-79
OCT - 5 1979

(If additional description is necessary, use BACK of this sheet)
Name of Plugging Contractor CLARKE CORPORATION

STATE OF Kansas COUNTY OF Barber, ss.
Elmer R. Morgenstern (employee of owner) or (owner or operator)
of the above-described well, being first duly sworn on oath, says: That I have knowledge of the facts, statements, and matters herein contained and the log of the above-described well as filed and that the same are true and correct. So help me God.

(Signature) Elmer R. Morgenstern
Medicine Lodge, Kansas
(Address)

SUBSCRIBED AND SWORN TO before me this 6th day of July, 19 79

Jesse Hamilton
Notary Public.


My commission expires April 4, 1982.

15-077-20517-0000

WELL : Muir C # 1

LOCATION : 330' FNL + 1650' FWL SEC. 27 - 31 S - 8 W HARPER COUNTY, KANSAS.

ELEVATION : 1594' G.L. 1600' K.B.

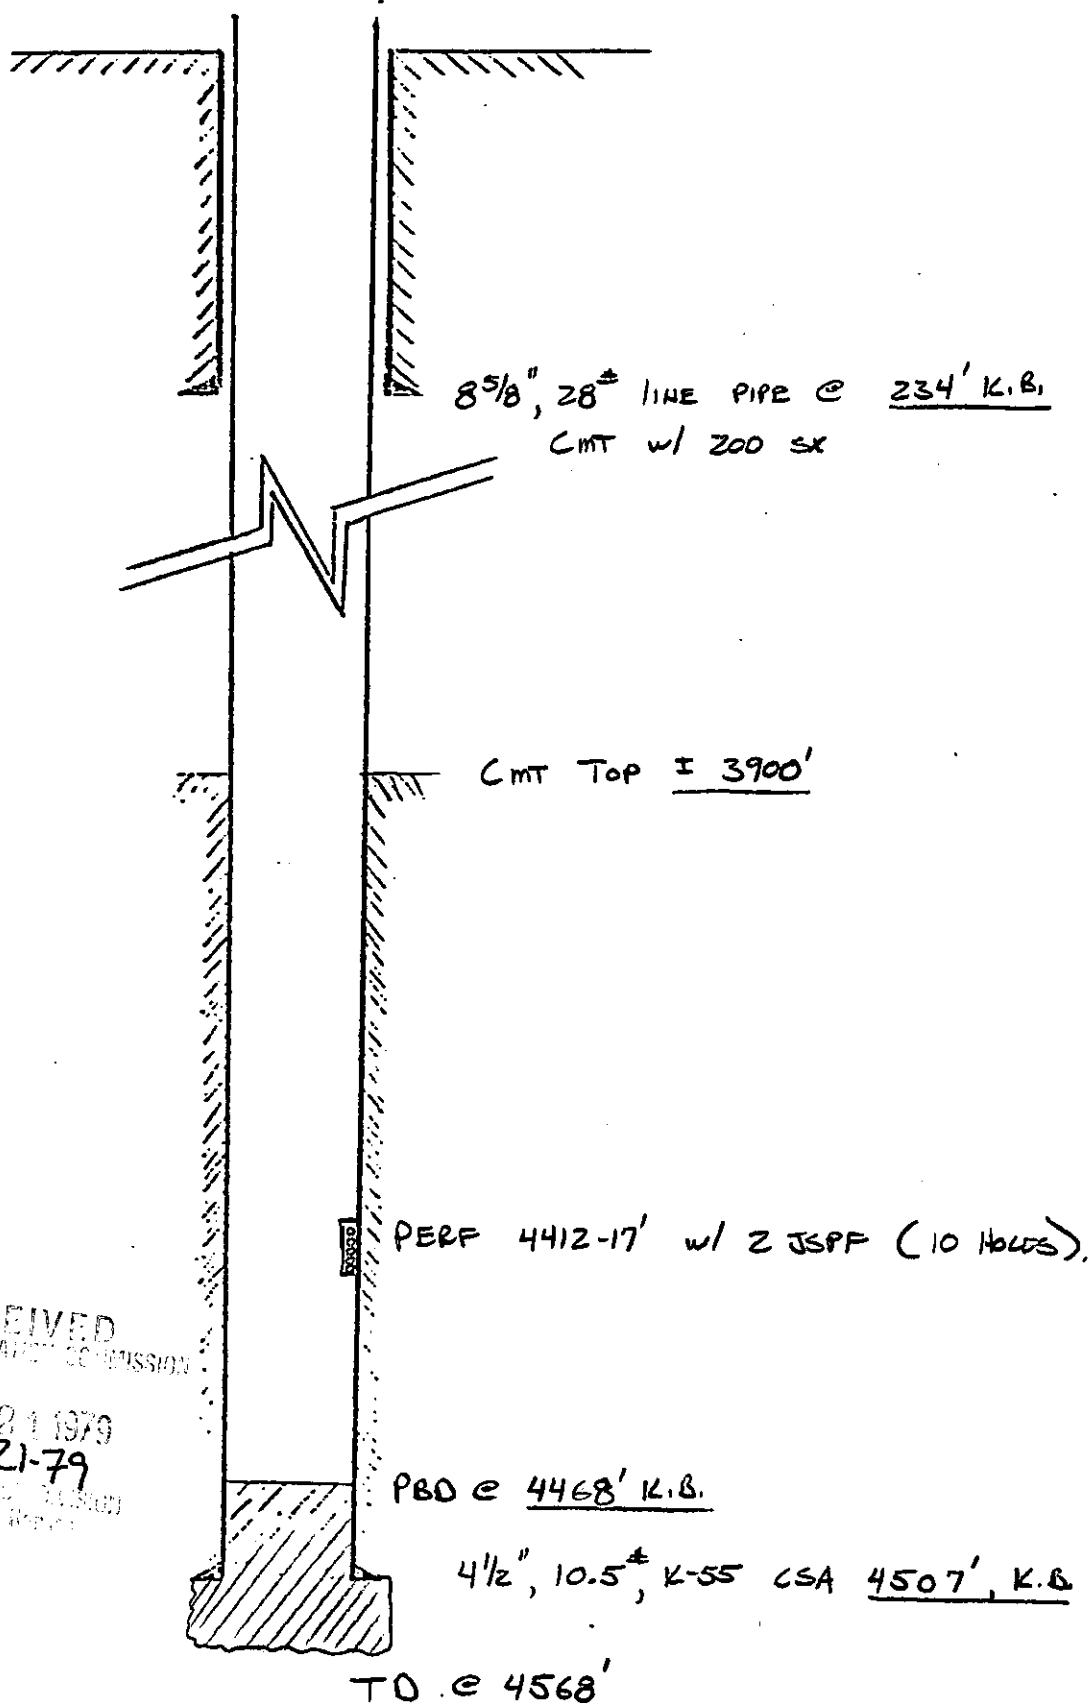

RECEIVED
STATE CONSERVATION COMMISSION

JUN 21 1979
6-21-79
DISTRICT OFFICE