


STATE OF KANSAS
STATE CORPORATION COMMISSION

WELL PLUGGING RECORD

Give All Information Completely
Make Required Affidavit
Mail or Deliver Report to
Conservation Division
State Corporation Comm.
245 North Water
Wichita, KS 67202

Barber County, Sec. 13 Twp. 31 Rge. 15 E/W
Location as "NE/CNW $\frac{1}{4}$ SW $\frac{1}{4}$ " or footage from lines
50' NW of C NW SE

Lease Owner Vincent Oil Corporation
Lease Name Thompson Well No. 1
Office Address 230 O. W. Garvey Building, Wichita 67202
Character of Well (Completed as Oil, Gas or Dry Hole)
Dry Hole

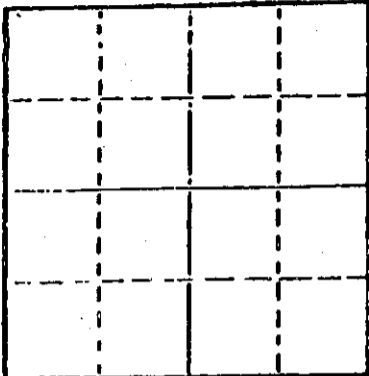

Locate well correctly on above
Section Plot

Date Well completed 11/4/79 19
Application for plugging filed 11/4/79 19
Application for plugging approved 11/4/79 19
Plugging commenced 11/4/79 19
Plugging completed 11/4/79 19
Reason for abandonment of well or producing formation

If a producing well is abandoned, date of last production 19

Was permission obtained from the Conservation Division or
its agents before plugging was commenced? Yes

Name of Conservation Agent who supervised plugging of this well Wm. T. Owen
Producing formation Depth to top Bottom Total Depth of Well
Show depth and thickness of all water, oil and gas formations. RTD 4780

OIL, GAS OR WATER RECORDS

CASING RECORD

FORMATION	CONTENT	FROM	TO	SIZE	PUT IN	PULLED OUT
	Surface	0	815	8-5/8	yes	no

Describe in detail the manner in which the well was plugged, indicating where the mud fluid was placed and the method or methods used in introducing it into the hold. If cement or other plugs were used, state the character of same and depth placed, from _____ feet to _____ feet for each plug set.

1st plug at 810' with 40 sacks
2nd plug @ 40' with 10 sacks
5 sacks in rathole
Job complete @ 7:15 P.M. 11/4/79

(If additional description is necessary, use BACK of this sheet)

Name of Plugging Contractor Slawson Drilling Company, Inc.

STATE OF Kansas COUNTY OF Sedgwick, ss.
James C. Rensberg, Slawson Drilling Company, Inc. (employee of owner) or (owner or operator)
of the above-described well, being first duly sworn on oath, says: That I have knowledge of
the facts, statements, and matters herein contained and the log of the above-described well
as filed and that the same are true and correct. So help me God.


(Signature)

James C. Rensberg
James C. Rensberg
200 Douglas Building, Wichita, Kansas 67202
(Address)

SUBSCRIBED AND SWORN TO before me this 19 day of November, 1979

Mary Lou Taylor
Mary Lou Taylor Notary Public.

My commission expires January 17, 1981

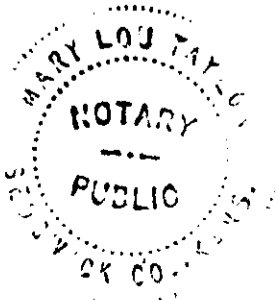

RECEIVED
STATE CORPORATION COMMISSION

NOV 20 1979

CONSERVATION DIVISION
Wichita, Kansas

DRILLERS LOG

OPERATOR: Vincent Oil Corporation
230 O. W. Garvey Building
Wichita, Kansas 67202

LEASE: Thompson #1
50' NW of C NW SE
Sec. 13-31S-15W
Barber County, Kansas

CONTRACTOR: Slawson Drilling Company, Inc.
200 Douglas Building
Wichita, Kansas 67202

COMMENCED: 10/25/79

COMPLETED: 11/4/79

RTD: 4780'

CONDUCTOR PIPE: 58'

SURFACE CASING: 8-5/8" set at 815' with 550 sx cement

0' to 58' Conductor pipe
58' to 819' 12½" Surface Hole
819' to 885' Red Bed
885' to 1940' Shale
1940' to 2533' Lime & Shale
2533' to 2775' Shale & Lime
2775' to 3085' Lime & Shale
3085' to 3295' Shale & Lime
3295' to 4663' Lime & Shale
4663' to 4747' Simpson
4747' to 4780' Arbuckle
RTD 4780'

STATE OF KANSAS

COUNTY OF SEDGWICK

I, James C. Rensberg of the Slawson Drilling Company, Inc.
hereby state the above and foregoing is an accurate copy of the
Thompson #1 log for Vincent Oil Corporation.


James C. Rensberg

Subscribed and sworn to me this
19th day of November, 1979


Mary Lou Taylor, Notary

My commission expires January 17, 1981

RECEIVED
STATE CORPORATION COMMISSION

NOV 20 1979

CONSERVATION DIVISION
Wichita, Kansas

