

STATE CORPORATION COMMISSION OF KANSAS  
OIL & GAS CONSERVATION DIVISION

WELL COMPLETION OR RECOMPLETION FORM  
ACO-1 WELL HISTORY

DESCRIPTION OF WELL AND LEASE

Operator: license # 5232  
name Pinto Petroleum  
address P.O. Box 18610 11184  
City/State/Zip Wichita, Ks. 67218 67211

Operator Contact Person Carl Nord Bob Watchous  
Phone (316) 263-4961 683-8152

Contractor: license # 5147  
name BEREDCO, INC.

Wellsite Geologist Ann Watchous  
Phone (316) 683-8152

PURCHASER  
Designate Type of Completion  
 New Well  Re-Entry  Workover

- Oil  SWD  Temp Abd
- Gas  Inj  Delayed Comp.
- Dry  Other (Core, Water Supply etc.)

If OWWO: old well info as follows:

Operator  
Well Name  
Comp. Date  
Old Total Depth  
Wichita, Kansas

WELL HISTORY

Drilling Method:  Mud Rotary  Air Rotary  Cable  
Spud Date 02/01/85 Date Reached TD 2/8/85 Completion Date 2/8/85  
Total Depth 4690' PBTD  
Amount of Surface Pipe Set and Cemented at 292 feet  
Multiple Stage Cementing Collar Used?  Yes  No  
If Yes, Show Depth Set \_\_\_\_\_ feet  
If alternate 2 completion, cement circulated from \_\_\_\_\_ feet depth to \_\_\_\_\_ w/ \_\_\_\_\_ SX cmt

API NO. 15- 101-21,124 0000

County LANE COUNTY

SW SW SE Sec 5 Twp 19S Rge 30W

..... 330 Ft North from Southeast Corner of Section  
..... 2310 Ft West from Southeast Corner of Section  
(Note: locate well in section plat below)


Lease Name ZERENER Well# #1

Field Name Un-named

Producing Formation D & A

Elevation: Ground 2897 KB 2902

Section Plat

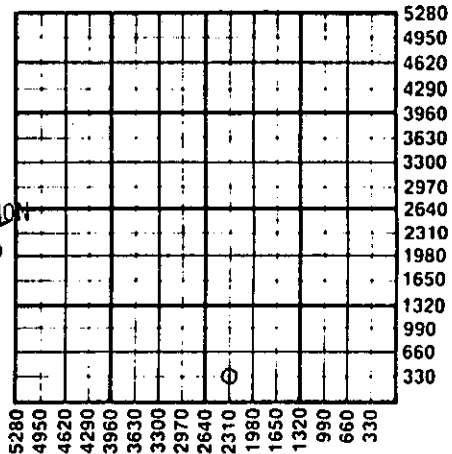

RECEIVED  
STATE CORPORATION COMMISSION  
3-20-85  
MARCH 20 1985  
CONSERVATION DIVISION  
Wichita, Kansas

WATER SUPPLY INFORMATION

Source of Water:  
Division of Water Resources Permit #  
 Groundwater..... Ft North From Southeast Corner and  
(Well) ..... Ft. West From Southeast Corner of  
Sec Twp Rge  East  West  
 Surface Water..... Ft North From Southeast Corner and  
(Stream, Pond etc.)..... Ft West From Southeast Corner  
Sec Twp Rge  East  West  
 Other (explain) hauled water fr well - Jerry Erkins  
(purchased from city, R.W.D.#)

Disposition of Produced Water:  Disposal  Repressuring  
Docket #

**INSTRUCTIONS:** This form shall be completed in duplicate and filed with the Kansas Corporation Commission, 200 Colorado Derby Building, Wichita, Kansas 67202, within 90 days after completion or recompletion of any well. Rules 82-3-130 and 82-3-107 apply.  
Information on side two of this form will be held confidential for a period of 12 months if requested in writing and submitted with the form. See rule 82-3-107 for confidentiality in excess of 12 months.  
One copy of all wireline logs and drillers time log shall be attached with this form. Submit CP-4 form with all plugged wells. Submit CP-111 form with all temporarily abandoned wells.

All requirements of the statutes, rules, and regulations promulgated to regulate the oil and gas industry have been fully complied with and the statements herein are complete and correct to the best of my knowledge.

Signature Bob Watchous  
Title Partner Date 3-19-85  
Subscribed and sworn to before me this 19th day of March 19 85  
Notary Public Kathryn L. Frerking  
Date Commission Expires August 21, 1985

KATHRYN L. FRERKING  
NOTARY PUBLIC  
STATE OF KANSAS  
MY APPT. EXPIRES 8-21-85

K.C.C. OFFICE USE ONLY  
F  Letter of Confidentiality Attached  
C  Wireline Log Received  
C  Drillers Timelog Received  
Distribution  
 KCC  SWD/Rep  NGPA  
 KGS  Plug  Other  
(Specify)

Sec. 5, Twp. 19, Rge. 30W

Operator Name PINTO PETROLEUM Lease Name ZERENER Well# 1 SEC 5 TWP 19S RGE 30W  East  West

WELL LOG

INSTRUCTIONS: Show important tops and base of formations penetrated. Detail all cores. Report all drill stem tests giving interval tested, time tool open and closed, flowing and shut-in pressures, whether shut-in pressure reached static level, hydrostatic pressures, bottom hole temperature, fluid recovery, and flow rates if gas to surface during test. Attach extra sheet if more space is needed. Attach copy of log.


Drill Stem Tests Taken  Yes  No
Samples Sent to Geological Survey  Yes  No
Cores Taken  Yes  No
Formation Description  Log  Sample

Table with 3 columns: Name, Top, Bottom. Rows include sand/shale, shale, sand/shale, lime/shale, Ks. City/Lime/shale, Lime/shale, KANSAS CITY, Marmaton/Ft.Scott, Lime/shale, Mississippi.

PINTO PETROLEUM P.O. BOX 11184 WICHITA, KS 67211 #1 ZERENER 5-19-30W SW SW SE

CONTR BEREDCO, INC. CITY LANE
GEOL BOB WATCHOUS FIELD UNNAMED EXT (1/8 N)

ELV 2902 KB SPD 2/1/85 CARD ISSUED 2/21/85 IP D&A/MISS 2/8/85

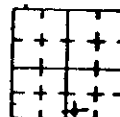

LOG table with columns: LOG, Tops, Depth/Datum. Lists various geological layers like ANH, HEEB, LKC, etc. with their respective depths.

API 15-101-21,124
8 5/8" 292
DST (1) 4540-87 (FT SC, CHER) / 20-20-20-20, REC 5' M, W / SSO, SIP 218-218#, FP 69-69 / 79-79#
DST (2) 4540-4605 (CHER, MISS) / 30-30-15-30, REC 20' M, SIP 238-218#, FP 49-49 59-59#

Large form containing CASING RECORD, PERFORATION RECORD, Acid, Fracture, Shot, Cement Squeeze Record, TUBING RECORD, and production data. Includes fields for size hole drilled, size casing set, weight lbs/ft, setting depth, type of cement, # sacks used, etc.

Disposition of gas:  vented  sold  used on lease

METHOD OF COMPLETION  open hole  perforation  other (specify)
 Dually Completed.
 Commingled

PRODUCTION INTERVAL