

This form shall be filed in duplicate with the Kansas Corporation Commission, 200 Colorado Derby Building, Wichita, Kansas 67202, within ten days after the completion of the well, regardless of how the well was completed.

Attach separate letter of request if the information is to be held confidential. If confidential, only file one copy. Information on side one will be of public record and side two will then be held confidential.

Circle one: Oil, Gas, Dry, SWD, OWWO, Injection. Type and complete ALL sections. Applications must be filed for dual completion, commingling, SWD and injection, T.A.

Attach wireline logs (i.e. electrical log, sonic log, gamma ray neutron log, etc.). KCC # (316) 263-3238. (Rules 82-2-105 & 82-2-125)

OPERATOR Thunderbird Drilling, Inc.

API NO. 15-101-20,619 7777D

ADDRESS P.O. Box 18407

COUNTY Lane

Wichita, Kansas 67218

FIELD Jernison

**CONTACT PERSON Gloria DeJesus

PROD. FORMATION

PHONE (316) 685-1441

LEASE Jernison "I"

PURCHASER

WELL NO. 1

ADDRESS


WELL LOCATION NW SE NE

990 Ft. from East Line and

990 Ft. from South Line of

the NE/4 SEC. 29 TWP. 16S RGE. 29W

WELL PLAT

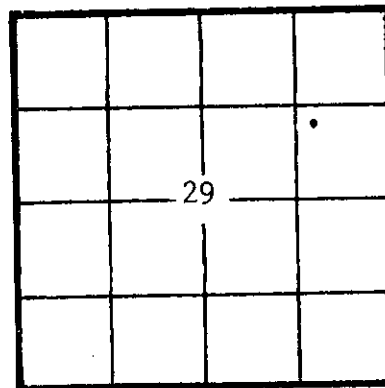

KCC [check] KGS [check] (Office Use)

PLUGGING Thunderbird Drilling, Inc.

CONTRACTOR

ADDRESS Same as above

TOTAL DEPTH 4532 PBDT

SPUD DATE 2/25/82 DATE COMPLETED 3/9/82

ELEV: GR 2774 DF KB 2779

DRILLED WITH (CORDEX) (ROTARY) (TKK) TOOLS

Amount of surface pipe set and cemented 324'w/235 sx. DV Tool Used? no

AFFIDAVIT

STATE OF KANSAS, COUNTY OF SEDGWICK SS, I,

Burke Krueger OF LAWFUL AGE, BEING FIRST DULY SWORN UPON HIS OATH,

DEPOSES THAT HE IS Vice-President (FOR)(OF) Thunderbird Drilling, Inc.

OPERATOR OF THE Jernison "I" LEASE, AND IS DULY AUTHORIZED TO MAKE

THIS AFFIDAVIT FOR AND ON THE BEHALF OF SAID OPERATOR, THAT WELL NO. 1 ON

SAID LEASE HAS BEEN COMPLETED AS OF THE 8th DAY OF April, 19 82, AND THAT

ALL INFORMATION HEREIN WITH RESPECT TO SAID WELL IS TRUE AND CORRECT.

FURTHER AFFIANT'S OATH AND SIGNATURE BEFORE ME THIS 8th DAY OF April, 19 82. CONSERVATION DIVISION Wichita, Kansas

(S) [Signature]



BEFORE ME THIS 8th DAY OF April, 19 82.

[Signature] NOTARY PUBLIC

MY COMMISSION EXPIRES: 3-25-84

**The person who can be reached by phone regarding any questions concerning this information. Within 45 days of completion, a witnessed initial test by the Commission is required if the well produces more than 25 BOPD or is located in a Basic Order Pool.

Show all important zones of porosity and contents thereof; cased intervals, and all drill-stem tests, including depth interval tested, cushion used, time tool open, flowing and shut-in pressures, and recoveries.

FORMATION DESCRIPTION, CONTENTS, ETC.	TOP	BOTTOM	NAME	DEPTH
DST #1, 4190-4210/30-30-30-30, rec. 15' FP 30-36#, BHP 981-935#	osm,		LOG TOPS: Anhydrite B/Anhydrite Heebner Lansing BKC Marmaton Pawnee Fort Scott Cherokee Miss LTD	
DST #2, 4340-4410/30-30-30-30, rec. 10' FP 82-82#, BHP 201-128#	sosm,			2184+ 595
DST #3, 4392-4440/60-45-60-45, rec. 15' 5' c.o., 40' gocm, FP 73-82#, BHP 357-210#	gip,			2199+ 580
				3866-1087
				3902-1123
				4248-1469
				4276-1497
				4354-1575
				4412-1633
				4438-1659
Surface hole	0	324		
Shale	324	1046		
Sand	1046	1120		
Shale	1120	1145		
Shale & Sand	1145	1920		
Sand & Shale	1920	2142		
Anhydrite	2142	2170		
Shale	2170	2220		
Shale & lime strks.	2220	2665		
Shale	2665	2830		Shale
Shale & Lime	2830	3465		
Lime & Shale	3465	3930		
Lime	3930	4532		
RTD	4532			

Report of all strings set— surface, intermediate, production, etc. CASING RECORD (New) or (Used)

Purpose of string	Size hole drilled	Size casing set (in O.D.)	Weight lbs/ft.	Setting depth	Type cement	Sacks	Type and percent additives
Surface	12 1/4	8 5/8"	24#	324'	com	235	2% gel, 3% cc.

LINER RECORD

PERFORATION RECORD

Top, ft.	Bottom, ft.	Sacks cement	Shots per ft.	Size & type	Depth interval

Size	Setting depth	Packer set at

ACID, FRACTURE, SHOT, CEMENT SQUEEZE RECORD

Amount and kind of material used	Depth interval treated

Date of first production	Producing method (flowing, pumping, gas lift, etc.)	Gravity
RATE OF PRODUCTION PER 24 HOURS	OR Gas bbls. MCF	Water % bbls. CFPB
Disposition of gas (vented, used on lease or sold)		Perforations