

F+B

This form shall be filed in duplicate with the Kansas Corporation Commission, 200 Colorado Derby Building, Wichita, Kansas 67202, within ten days after the completion of the well, regardless of how the well was completed.

Attach separate letter of request if the information is to be held confidential. If confidential, only file one copy. Information on side one will be of public record and side two will then be held confidential.

Circle one: Oil, Gas, Dry, SWD, OWWO, Injection. Type and complete ALL sections. Applications must be filed for dual completion, commingling, SWD and injection, T.A.

Attach wireline logs (i.e. electrical log, sonic log, gamma ray neutron log, etc.). KCC # (316) 263-3238. (Rules 82-2-105 & 82-2-125)

OPERATOR Walters Drilling Company, Inc.
ADDRESS 420 Hardage Center
Wichita, Kansas 67202

API NO. 15-135-22,178
COUNTY Ness
FIELD WC

**CONTACT PERSON Robert F. Walters
PHONE (316) 265-6683

PROD. FORMATION
LEASE FOOS

PURCHASER
ADDRESS


WELL NO. 1
WELL LOCATION 50' West of SE SW NE

DRILLING Slawson Drilling Company, Inc.
CONTRACTOR
ADDRESS 200 Douglas Building
Wichita, Kansas 67202

940 Ft. from West Line and
330 Ft. from South Line of
the NE/4 SEC. 33 TWP. 17 RGE. 23W

PLUGGING Halliburton Cement
CONTRACTOR
ADDRESS

WELL PLAT

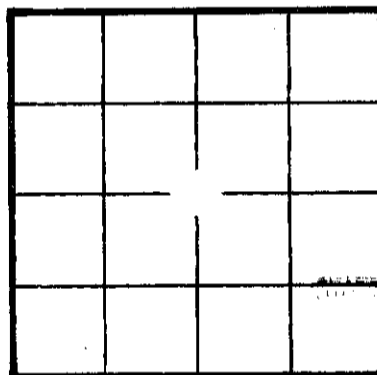

KCC
KGS
(Office Use)

TOTAL DEPTH 4390' PBTD

SPUD DATE 11/30/81 DATE COMPLETED 12/9/81

ELEV: GR 2340 DF 2345 KB 2346

DRILLED WITH XAMEN (ROTARY) XATX XTOX

RECEIVED
JAN 13 1982

Amount of surface pipe set and cemented 442' with 275 sx . DV Tool Used?

AFFIDAVIT

STATE OF KANSAS, COUNTY OF SEDGWICK SS, I, Robert F. Walters

DEPOSES THAT HE IS President (FOR) (OF) Walters Drilling Co., Inc.

OPERATOR OF THE Foos LEASE, AND IS DULY AUTHORIZED TO MAKE

THIS AFFIDAVIT FOR AND ON THE BEHALF OF SAID OPERATOR, THAT WELL NO. 1 ON

SAID LEASE HAS BEEN COMPLETED AS OF THE 9th DAY OF December, 19 81, AND THAT

ALL INFORMATION ENTERED HEREIN WITH RESPECT TO SAID WELL IS TRUE AND CORRECT.

FURTHER AFFIANT SAITH NOT.

(S) Robert F. Walters

SUBSCRIBED AND SWORN BEFORE ME THIS 8th DAY OF January, 19 82

Linda L. Boushon LINDA L. BUSHON
NOTARY PUBLIC STATE OF KANSAS
My Comm. Exp. 10-14-85

MY COMMISSION EXPIRES: 10-14-85

**The person who can be reached by phone regarding any questions concerning this information. Within 45 days of completion, a witnessed initial test by the Commission is required if the well produces more than 25 BOPD or is located in a Basic Order Pool.

Show all important zones of porosity and contents thereof; cored intervals, and all drill-stem tests, including depth interval tested, cushion used, time tool open, flowing and shut-in pressures, and recoveries.

SHOW GEOLOGICAL MARKERS, LOGS RUN, OR OTHER DESCRIPTIVE INFORMATION.

FORMATION DESCRIPTION, CONTENTS, ETC.	TOP	BOTTOM	NAME	DEPTH
<p>DST #1 (4314 - 4374) Conglomerate</p> <p>30 - 30 - 30 - 30. Very weak blow. 5 min. & died. Recovered 10' mud - show of oil in tool. FP: 46-46-46-46 SIP: 138 - 92; HP: 2181 - 2158</p>			ELECTRIC LOG TOPS:	
			Anhydrite	1624 (+722)
			B/Anhydrite	1661 (+685)
			Topeka	3430 (-1084)
			Heebner	3733 (-1387)
			Lansing	3772 (-1426)
			B/Kansas City	4064 (-1718)
			Pawnee	4172 (-1826)
			Ft. Scott	4271 (-1925)
			Cherokee Shale	4292 (-1946)
		Cherokee Sand	4352 (-2006)	
		Mississippian	4370 (-2024)	

Report of all strings set— surface, intermediate, production, etc. **CASING RECORD** (New) or (Used)

Purpose of string	Size hole drilled	Size casing set (in O.D.)	Weight lbs/ft.	Setting depth	Type cement	Sacks	Type and percent additives
Surface	12-1/4"	8-5/8"	24#	442	Common	275	60/40 poz 2% gel 3% cc

LINER RECORD

PERFORATION RECORD

Top, ft.	Bottom, ft.	Sacks cement	Shots per ft.	Size & type	Depth interval

TUBING RECORD

Size	Setting depth	Packer set at

ACID, FRACTURE, SHOT, CEMENT SQUEEZE RECORD

Amount and kind of material used	Depth interval treated

Date of first production	Producing method (flowing, pumping, gas lift, etc.)	Gravity
--------------------------	---	---------

RATE OF PRODUCTION PER 24 HOURS	Oil	Gas	Water	Gas-oil ratio
	bbls.	bbls.	MCF	bbls.

Disposition of gas (vented, used on lease or sold)	Perforations
--	--------------