

SIDE ONE

STATE CORPORATION COMMISSION OF KANSAS
OIL & GAS CONSERVATION DIVISION
RECOMPLETION FORM
ACO-2 AMENDMENT TO WELL HISTORY

Operator: License # 5027

Name: J. A. ALLISON

Address: 300 West Douglas, Suite 305

City/State/Zip: Wichita, KS 67202

Purchaser: Prairie Gas Transportation Co.
Clear Creek, Inc.

Operator Contact Person: J. A. Allison
Phone: (316) 262-2241

Designate Type of Original Completion
 New Well Re-Entry Workover

Date of Original Completion Sept. 18, 1982

Name of Original Operator J. A. Allison

Original Well Name SHRIVER "B"

Date of Recompletion:
Aug. 17, 1990 Aug. 22, 1990
Commenced Completed

Re-entry Workover

Designate Type of Recompletion/Workover:
 Oil SWD Temp. Abd.
 Gas Inj Delayed Comp.
 Dry Other (Core, Water Supply, etc.)
 Squeeze K.C.Perfs.
 Deepening Re-perforation
 Plug Back PBTB
 Conversion to Injection/Disposal

Is recompleted production:
 Commingled Docket No. _____
 Dual Completion Docket No. _____
 Other (Disposal or Injection?) Docket No. _____

API NO. 15- 151-21,164-0001

County PRATT

NW SE NE Sec. 9 Twp. 26 Rge. 11 East West

3630 Ft. North from Southeast Corner of Section

990 Ft. West from Southeast Corner of Section


(NOTE: Locate well in section plat below.)

Lease Name SHRIVER "B" Well # 1

Field Name Stark East

Producing Formation *MISSISSIPPI (Formerly Kansas City)

Elevation: Ground 1829 KB 1844

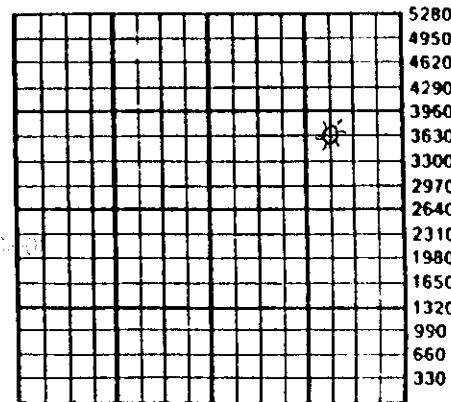

K.C.C. OFFICE USE ONLY
F Letter of Confidentiality Attached
C Wireline Log Received
C Drillers Timelog Received

Distribution
 KCC SWD/Rep NGPA
 KGS Plug Other
(Specify)

INSTRUCTIONS: This form shall be completed in triplicate and filed with the Kansas Corporation Commission, 200 Colorado Derby Building, Wichita, Kansas 67202, within 120 days of the recompletion of any well. Rules 82-3-107 and 82-3-141 apply. Information on side two of this form will be held confidential for a period of 12 months if requested in writing and submitted with the form. See rule 82-3-107 for confidentiality in excess of 12 months. One copy of any additional wireline logs and driller's time logs (not previously submitted) shall be attached with this form. Submit ACO-4 or ACO-5 prior to or with this form for approval of commingling or dual completions. Submit CP-1 with all plugged wells. Submit CP-111 with all temporarily abandoned wells. NOTE: Conversion of wells to either disposal or injection must receive approval before use; submit form U-1.

All requirements of the statutes, rules and regulations promulgated to regulate the oil and gas industry have been fully complied with and the statements herein are complete and correct to the best of my knowledge.

Signature J. A. Allison Title Operator Date January 14, 1991

Subscribed and sworn to before me this 14th day of January 19 91

Notary Public Frances O. Erhard Date Commission Expires Jan. 14, 1994
Frances O. Erhard



SIDE TWO

Operator Name L. A. ALLISON Lease Name SHRIVER "B" Well # 1
Sec. 9 Twp. 26 Rge. 11 East West
County PRATT

RECOMPLETION FORMATION DESCRIPTION

Log Sample

Name

Top

Bottom

* Forced to squeeze Kansas City perms due to fluid produced with gas from Mississippian.

ADDITIONAL CEMENTING/SQUEEZE RECORD

Purpose: <input type="checkbox"/> Perforate <input type="checkbox"/> Protect Casing <input type="checkbox"/> Plug Back TD <input type="checkbox"/> Plug Off Zone	Depth		Type of Cement	# Sacks Used	Type and Percent Additives
	Top	Bottom			

PERFORATION RECORD

Shots Per Foot	Specify Footage of Each Interval Perforated	Acid, Fracture, Shot, Cement Squeeze Record (Amount and Kind of Material Used)
*	3598-3603 (Kansas City) (These perms squeezed off)	
*	4028-4044 (Mississippi)	

PBTD 4014 Plug Type Baker Model "D" Production Packer

TUBING RECORD

Size 2-3/8" Set At 4014' Packer At - Was Liner Run Y X N
Date of Resumed Production, Disposal or Injection August 22, 1990
Estimated Production Per 24 Hours Oil 6 Bbls. Water 20 Bbls. Gas-Oil-Ratio
Gas 150 Mcf
Disposition of Gas: Vented Sold Used on Lease (If vented, submit ACO-18.)

SIDE ONE

STATE CORPORATION COMMISSION OF KANSAS
OIL & GAS CONSERVATION DIVISION
RECOMPLETION FORM
ACO-2 AMENDMENT TO WELL HISTORY

API NO. 15- 151-21,164-0001
County PRATT
NW SE NE Sec. 9 Twp. 26 Rge. 11 X East West


Operator: License # 5027
Name: J. A. ALLISON
Address: 300 West Douglas, Suite 305
City/State/Zip: Wichita, KS 67202

3630 Ft. North from Southeast Corner of Section
990 Ft. West from Southeast Corner of Section
(NOTE: Locate well in section plat below.)

Purchaser: Prairie Gas Transportation Co.
Clear Creek, Inc.
Operator Contact Person: J. A. Allison
Phone: (316) 262-2241

Lease Name SHRIVER "B" Well # 1
Field Name Stark East
Producing Formation *MISSISSIPPI (Formerly Kansas City)
Elevation: Ground 1829 KB 1844

Designate Type of Original Completion
 New Well Re-Entry X Workover
Date of Original Completion Sept. 18, 1982
Name of Original Operator J. A. Allison
Original Well Name SHRIVER "B"
Date of Recompletion:
Aug. 17, 1990 Aug. 22, 1990
Commenced Completed

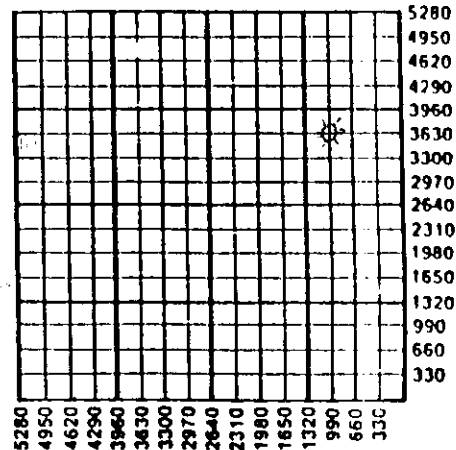

Re-entry Workover
Designate Type of Recompletion/Workover:
X Oil SWD Temp. Abd.
 Gas Inj Delayed Comp.
 Dry Other (Core, Water Supply, etc.)
 X Squeeze K.C.Perfs.
 Deepening Re-perforation
 Plug Back PBD
 Conversion to Injection/Disposal


K.C.C. OFFICE USE ONLY
F Letter of Confidentiality Attached
C Wireline Log Received
C Drillers Timelog Received

Distribution
 KCC SWD/Rep NGPA
 KGS Plug Other
(Specify)

Is recompleted production:
 Commingled Docket No.
 Dual Completion Docket No.
 Other (Disposal or Injection?)
Docket No.

INSTRUCTIONS: This form shall be completed in triplicate and filed with the Kansas Corporation Commission, 200 Colorado Derby Building, Wichita, Kansas 67202, within 120 days of the recompletion of any well. Rules 82-3-107 and 82-3-141 apply. Information on side two of this form will be held confidential for a period of 12 months if requested in writing and submitted with the form. See rule 82-3-107 for confidentiality in excess of 12 months. One copy of any additional wireline logs and driller's time logs (not previously submitted) shall be attached with this form. Submit ACO-4 or ACO-5 prior to or with this form for approval of commingling or dual completions. Submit CP-1 with all plugged wells. Submit CP-111 with all temporarily abandoned wells. NOTE: Conversion of wells to either disposal or injection must receive approval before use; submit form U-1.

All requirements of the statutes, rules and regulations promulgated to regulate the oil and gas industry have been fully complied with and the statements herein are complete and correct to the best of my knowledge.
Signature J. A. Allison Title Operator Date January 14, 1991
Subscribed and sworn to before me this 14th day of January 19 91
Notary Public Frances O. Erhard Date Commission Expires Jan. 14, 1994
Frances O. Erhard

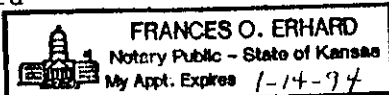

SIDE TWO

Operator Name L. A. ALLISON Lease Name SHRIVER "B" Well # 1
Sec. 9 Twp. 26 Rge. 11 East West
County PRATT

RECOMPLETION FORMATION DESCRIPTION

Log Sample

Name

Top

Bottom

* Forced to squeeze Kansas City perms due to fluid produced with gas from Mississippian.

ADDITIONAL CEMENTING/SQUEEZE RECORD

Purpose: <input type="checkbox"/> Perforate <input type="checkbox"/> Protect Casing <input type="checkbox"/> Plug Back TD <input type="checkbox"/> Plug Off Zone	Depth		Type of Cement	# Sacks Used	Type and Percent Additives
	Top	Bottom			

PERFORATION RECORD

Shots Per Foot	Specify Footage of Each Interval Perforated	Acid, Fracture, Shot, Cement Squeeze Record (Amount and Kind of Material Used)
*	3598-3603 (Kansas City) (These perms squeezed off)	
*	4028-4044 (Mississippi)	

BTD 4014 Plug Type Baker Model "D" Production Packer

TUBING RECORD

Size 2-3/8" Set At 4014' Packer At - Was Liner Run Y X N
Date of Resumed Production, Disposal or Injection August 22, 1990
Estimated Production Per 24 Hours Oil 6 Bbls. Water 20 Bbls. Gas-Oil-Ratio
Disposition of Gas: Gas 150 Mcf

Vented Sold Used on Lease (If vented, submit ACO-18.)

SIDE ONE

STATE CORPORATION COMMISSION OF KANSAS
OIL & GAS CONSERVATION DIVISION
RECOMPLETION FORM
ACO-2 AMENDMENT TO WELL HISTORY


Operator: License # 5027
Name: J. A. ALLISON
Address: 300 West Douglas, Suite 305
City/State/Zip: Wichita, KS 67202
Purchaser: Prairie Gas Transportation Co.
Clear Creek, Inc.
Operator Contact Person: J. A. Allison
Phone: (316) 262-2241

Designate Type of Original Completion
 New Well Re-Entry Workover
Date of Original Completion Sept. 18, 1982
Name of Original Operator J. A. Allison
Original Well Name SHRIVER "B"
Date of Recompletion: Aug. 17, 1990 Aug. 22, 1990
Commenced Completed

Re-entry Workover
Designate Type of Recompletion/Workover:
 Oil SWD Temp. Abd.
 Gas Inj Delayed Comp.
 Dry Other (Core, Water Supply, etc.)
 Squeeze K.C.Perfs.
 Deepening Re-perforation
 Plug Back PBTD
 Conversion to Injection/Disposal

Is recompleted production:
 Commingled Docket No. _____
 Dual Completion Docket No. _____
 Other (Disposal or Injection?)
Docket No. _____

API NO. 15- 151-21,164-0001
County PRATT
NW SE NE Sec. 9 Twp. 26 Rge. 11 East West
3630 Ft. North from Southeast Corner of Section
990 Ft. West from Southeast Corner of Section
(NOTE: Locate well in section plat below.)
Lease Name SHRIVER "B" Well # 1
Field Name Stark East
Producing Formation* MISSISSIPPI (Formerly Kansas City)
Elevation: Ground 1829 KB 1844

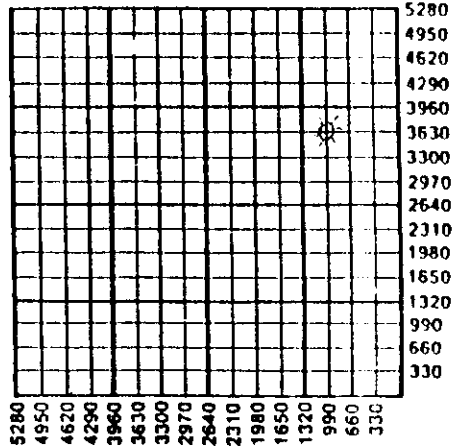

K.C.C. OFFICE USE ONLY
F Letter of Confidentiality Attached
C Wireline Log Received
C Drillers Timelog Received
Distribution
 KCC SWD/Rep NGPA
 KGS Plug Other
(Specify)

INSTRUCTIONS: This form shall be completed in triplicate and filed with the Kansas Corporation Commission, 200 Colorado Derby Building, Wichita, Kansas 67202, within 120 days of the recompletion of any well. Rules 82-3-107 and 82-3-141 apply. Information on side two of this form will be held confidential for a period of 12 months if requested in writing and submitted with the form. See rule 82-3-107 for confidentiality in excess of 12 months. One copy of any additional wireline logs and driller's time logs (not previously submitted) shall be attached with this form. Submit ACO-4 or ACO-5 prior to or with this form for approval of commingling or dual completions. Submit CP-1 with all plugged wells. Submit CP-111 with all temporarily abandoned wells. NOTE: Conversion of wells to either disposal or injection must receive approval before use; submit form U-1.

All requirements of the statutes, rules and regulations promulgated to regulate the oil and gas industry have been fully complied with and the statements herein are complete and correct to the best of my knowledge.
Signature J. A. Allison Title Operator Date January 14, 1991
Subscribed and sworn to before me this 14th day of January 19 91
Notary Public Frances O. Erhard Date Commission Expires Jan. 14, 1994
Frances O. Erhard

FRANCES O. ERHARD
Notary Public - State of Kansas
My Appt. Expires 1-14-94

SIDE TWO

Operator Name J. A. ALLISON

Lease Name SHRIVER "B"

Well # 1

Sec. 9 Twp. 26 Rge. 11
 East
 West

County PRATT

RECOMPLETION FORMATION DESCRIPTION

Log Sample

Name

Top

Bottom

* Forced to squeeze Kansas City perms due to fluid produced with gas from Mississippian.

ADDITIONAL CEMENTING/SQUEEZE RECORD

Purpose:	Depth		Type of Cement	# Sacks Used	Type and Percent Additives
	Top	Bottom			
<input type="checkbox"/> Perforate					
<input type="checkbox"/> Protect Casing					
<input type="checkbox"/> Plug Back TD					
<input type="checkbox"/> Plug Off Zone					

Shots Per Foot	PERFORATION RECORD		Acid, Fracture, Shot, Cement Squeeze Record (Amount and Kind of Material Used)
	Specify Footage of Each Interval Perforated		
*	3598-3603 (Kansas City) (These perms squeezed off)		
*	4028-4044 (Mississippi)		

BTD 4014 Plug Type Baker Model "D" Production Packer

TUBING RECORD

Size 2-3/8" Set At 4014' Packer At - Was Liner Run - Y X N

Date of Resumed Production, Disposal or Injection August 22, 1990

Estimated Production Per 24 Hours Oil 6 Bbls. Water 20 Bbls. Gas 150 Mcf Gas-Oil-Ratio

Disposition of Gas:
Vented Sold Used on Lease (If vented, submit ACO-18.)