

STATE OF KANSAS
STATE CORPORATION COMMISSION
CONSERVATION DIVISION
P. O. BOX 17027
WICHITA, KANSAS 67217

FORM CP-4

WELL PLUGGING RECORD

Saline County, Sec. 36 Twp. 16S Rge. 1 (E) (W) X

Location as "NE/CNWKSW" or footage from lines: NW SE NW

Lease Owner: Halliburton Oil Producing Co.

Lease Name: #1 Vogts Well No. 1

Office Address: 117 Cameron Bldg., Oklahoma City, OKLA 73116

Character of Well (completed as Oil, Gas or Dry Hole): D&A

Date well completed: March 1 1976

Application for plugging filed: March 1 1976

Application for plugging approved: March 1 1976


Plugging commenced: March 1 1976

Plugging completed: March 1 1976

Reason for abandonment of well or producing formation: D&A

If a producing well is abandoned, date of last production: 19__

Was permission obtained from the Conservation Division or its agents before plugging was commenced? Yes

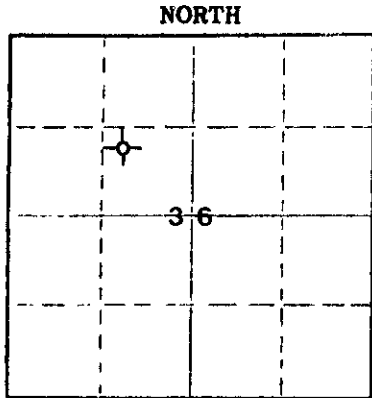

Locate well correctly on above Section Plat

Name of Conservation Agent who supervised plugging of this well: Hugh F. Scott

Producing formation: Depth to top: Bottom: Total Depth of Well: 2730 Feet

Show depth and thickness of all water, oil and gas formations.

OIL, GAS OR WATER RECORDS

CASING RECORD

FORMATION	CONTENT	FROM	TO	SIZE	PUT IN	PULLED OUT
				8-5/8"	153'	-0-

Describe in detail the manner in which the well was plugged, indicating where the mud fluid was placed and the method or methods used in introducing it into the hole. If cement or other plugs were used, state the character of same and depth placed, from feet to feet for each plug set.

25 sx @ 170'
Plug, 10 sx @ 40'
4 sx in rathole

RECEIVED
MAY 11 1976
3-11-76
CONSERVATION DIVISION
WICHITA, KANSAS

Name of Plugging Contractor: Red Tiger Drilling Company (If additional description is necessary, use BACK of this sheet)

Address: 1720 Wichita Plaza, Wichita, KS 67202

STATE OF Kansas, COUNTY OF Sedgwick

D'Ann Drennan (employee of owner) or (owner or operator) of the above-described well, being first duly sworn on oath, says: That I have knowledge of the facts, statements, and matters herein contained and the log of the above-described well as filed and that the same are true and correct. So help me God.

(Signature) D'Ann Drennan
1720 Wichita Plaza, Wichita, KS 67202 (Address)

SUBSCRIBED AND SWORN TO before me this 4th day of March, 1976

My commission expires 10-1-78 Notary Public.

15169.20075.0000

DRILLERS LOG

No. 1 Vogts

CASING RECORD:
8-5/8" @ 159'
150 sx com cmt

COMPANY: Halliburton Oil Producing Co.
CONTRACTOR: Red Tiger Drilling Co.
COMMENCED: February 26, 1976
COMPLETED: March 1, 1976

DESCRIPTION: NW SE NW
36-16S-1W
Saline County,
Kansas

ELEVATION

<u>FORMATION</u>	<u>FROM</u>	<u>TO</u>	<u>REMARKS</u>
Surface Soil & Rock	0	132	
Anhydrite	132	164	
Lime	164	1120	
Lime & Shale	1120	1415	
Shale & Lime	1415	1730	
Lime	1730	2355	
Lime & Shale	2355	2475	
Lime	2475	2730	
RTD		2730	


I certify that this is a true and correct copy of the above log to the best of my knowledge.

RED TIGER DRILLING COMPANY

Joyce A. Hagermann
Joyce A. Hagermann

Subscribed and sworn to before me this 4th day of March, 1976.

D'Ann Drennan
Notary Public

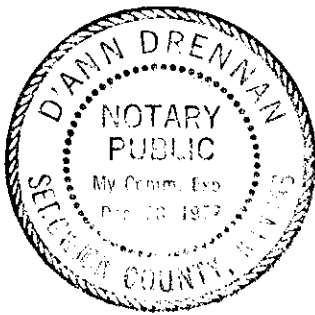

15169