

WELL PLUGGING RECORD

OR

FORMATION PLUGGING RECORD

Strike out upper line when reporting plugging off formations.

STATE OF KANSAS STATE CORPORATION COMMISSION

Give All Information Completely Make Required Affidavit Mail or Deliver Report to: Conservation Division State Corporation Commission 800 Bitting Building Wichita, Kansas

Saline County. Sec. 33 Twp. 16 Rge. (E) 14 (W)

Location as "NE 1/4 NW 1/4 SW 1/4" or footage from lines. Lease Owner: F. S. Williams. Lease Name: Stein. Office Address: McPherson, Kansas. Well No.: 1. Character of Well: Dry. Date well completed: 12-16-48. Application for plugging filed: 12-16-48. Application for plugging approved: 12-16-48. Plugging commenced: 12-17-48. Plugging completed: 12-17-48. Reason for abandonment of well or producing formation:



Locate well correctly on above Section Plat

If a producing well is abandoned, date of last production. Was permission obtained from the Conservation Division or its agents before plugging was commenced? Yes

Name of Conservation Agent who supervised plugging of this well: Mr. Noel Durkee McPherson, Kansas. Producing formation. Depth to top. Bottom. Total Depth of Well: 2643 Feet. Show depth and thickness of all water, oil and gas formations.


OIL, GAS OR WATER RECORDS

CASING RECORD

Table with 7 columns: Formation, Content, From, To, Size, Put In, Pulled Out. Entry: Size 8 5/8, Put In 122', Pulled Out Cemented with 80 Sacks.

Describe in detail the manner in which the well was plugged, indicating where the mud fluid was placed and the method or methods used in introducing it into the hole. If cement or other plugs were used, state the character of same and depth placed, from... feet to... feet for each plug set.

Circulated at bottom of hole for one hour with suction on bottom of pit. Half way out of hole circulated for one hour with suction on bottom of pit, at bottom of surface pipe ran 18 sacks of cement and 5 sacks at the top of the hole.

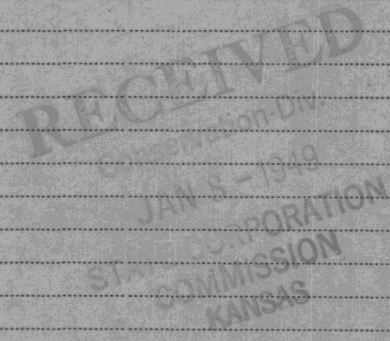

(If additional description is necessary, use BACK of this sheet)

Correspondence regarding this well should be addressed to: Mr. F. S. Williams. Address: McPherson, Kansas

STATE OF Kansas, COUNTY OF McPherson, ss. Gordon T. Adams (employee of owner) or (owner or operator) of the above-described well, being first duly sworn on oath, says: That I have knowledge of the facts, statements, and matters herein contained and the log of the above-described well as filed and that the same are true and correct. So help me God.

(Signature) by: Gordon T. Adams, The Veeder Supply & Development Co. (Address)

SUBSCRIBED AND SWORN to before me this 4th day of January, 1949. Curtis Nelson, Notary Public.

My commission expires

PLUGGING FILE SEC 33 T 16 R 14 BOOK PAGE 74 LINE 40

Veeder Supply & Dev'l. Co.

Cherryvale, Kansas

Drilled for F. S. (Tass) Williams Farm Stein No. 1 Depth 2643'
 Contractor Veeder Supply & Development Company Pipe 122' of 8 5/8" Casing Cemented with 80 sacks.
 Location SW SW SW Sec. 33 Twp. 16 Range 1W
 Commenced 12-8-48 Completed 12-17-48 County Saline State Kansas

Soil Clay Sand	0	50	50
Shale Shells	50	85	35
Shale	85	130	45
Anhydrite	130	230	100
Shale Anhydrite	230	315	85
Anhydrite	315	330	15
Lime Shale	330	790	460
Lime	790	910	120
Lime Shale	910	1025	115
Shale Shells	1025	1260	235
Shale Lime	1260	1520	260
Lime Shale	1520	1630	110
Lime	1630	1810	180
Lime Shale	1810	1955	145
Shale Lime Shells	1955	2002	47
Lime	2002	2150	148
Shale	2150	2190	40
Lime Shale	2190	2225	35
Lime	2225	2265	40
Shale Lime Shells	2265	2275	10
Lime	2275	2315	40
Shale Shells	2315	2385	70
Shale	2385	2420	35
Shale Shells	2420	2550	130
Shale	2550	2610	60
Chat	2610	2643	33
Total Depth	2643'		

AFFIDAVIT

STATE OF KANSAS
 MONTGOMERY COUNTY SS:

EMMETT C. VEEDER, of lawful age, being duly and solemnly sworn on oath says;
 I am a resident of Cherryvale, Montgomery County, Kansas, and I hereby know and
 on oath state, that the above drilling log covering the Stein #1 Well in
 Section 33-16-1W, Saline County, Kansas, is true and correct.
 Further affiant saith not.


THE VEEDER SUPPLY & DEVELOPMENT COMPANY

BY Emmett C. Veeder
 President

Subscribed and sworn to before me this 23rd day of December, 1948.

John Rawson
 Notary Public

My Commission Expires 7-11-52.

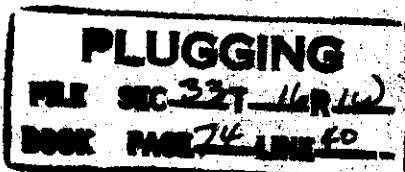

RECEIVED
 Conservation Div.
 JAN 8 - 1949
 STATE CORPORATION
 COMMISSION
 KANSAS