


15-169-00134-0000

WELL PLUGGING RECORD

Give All Information Completely
Make Required Affidavit
Mail or Deliver Report to:
Conservation Division
State Corporation Commission
212 North Market, Insurance Bldg.
Wichita, Kansas

Saline County. Sec. 33 Twp. 16 Rge. 1W (E) (W)

Location as "NE/CNW/SW" or footage from lines SW SW ~~NE~~ ~~NE~~ ~~NE~~
Lease Owner Hollar Oil Co.
Lease Name Stein Well No. 1 SWD
Office Address 1117 Wichita Plaza
Character of Well (completed as Oil, Gas or Dry Hole) SWD Lost Hole
Date well completed 8-1 19 53
Application for plugging filed 4-3-64 19
Application for plugging approved 4-3-64 19
Plugging commenced 8 A.M. 4-4-64 19
Plugging completed 11 A.M. 4-4-64 19
Reason for abandonment of well or producing formation Pipe eaten up. Could not clean out for further use.

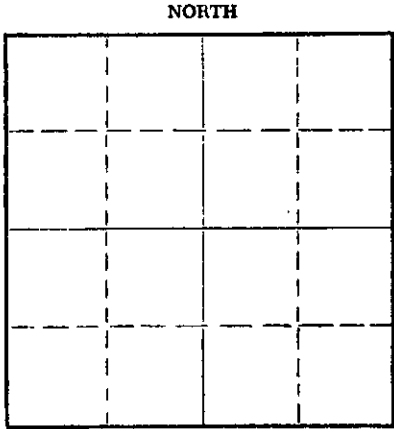

Locate well correctly on above Section Plat

If a producing well is abandoned, date of last production _____ 19____
Was permission obtained from the Conservation Division or its agents before plugging was commenced? Yes

Name of Conservation Agent who supervised plugging of this well Gilbert Toman, Holyrood
Producing formation _____ Depth to top _____ Bottom _____ Total Depth of Well 3669 Feet
Show depth and thickness of all water, oil and gas formations.

OIL, GAS OR WATER RECORDS

CASING RECORD

FORMATION	CONTENT	FROM	TO	SIZE	PUT IN	PULLED OUT
				10 3/4	117	0
				5 1/2"	3341	0

Describe in detail the manner in which the well was plugged, indicating where the mud fluid was placed and the method or methods used in introducing it into the hole. If cement or other plugs were used, state the character of same and depth placed, from _____ feet to _____ feet for each plug set.

Bridge 890. 10' sand, 5 sx. cement.

Bridge 145 to 135. 30 sx. to surface
Finished 11 A.M. 4-4-64

RECEIVED
STATE CORPORATION COMMISSION
APR 7 1964
CONSERVATION DIVISION
Wichita, Kansas

(If additional description is necessary, use BACK of this sheet)

Name of Plugging Contractor Sagamore Drilling Co.
Address 2927 Sagamore Road, Leawood, Kansas

STATE OF Kansas, COUNTY OF Sedgwick, ss.
Arland Bruce, Supt. (employee of owner) or (owner or operator) of the above-described well, being first duly sworn on oath, says: That I have knowledge of the facts, statements, and matters herein contained and the log of the above-described well as filed and that the same are true and correct. So help me God.

(Signature) Arland Bruce

Box 620, McPherson, Kansas
(Address)

SUBSCRIBED AND SWORN TO before me this 6th day of April, 19 64

Helen Horine
Notary Public.

My commission expires 6-4-67



ROTARY DRILLER'S LOG

E. K. Carey Drilling Co., Inc., - Operator Elevations: 1282 K. B.
 Box 620 1279 D. F.
 McPherson, Kansas

10-3/4" x 5 1/2" Head 8'
 below K. B.

Stein "A" #1 S. W. D.

Casing Record:

C, SW SW NE/4
 Sec. 33-16-1W
 Saline County, Kansas

10-3/4" @ 117' w/100 sks of
 Lehigh and 100# c.c. cemented
 on bottom.
 5-1/2" @ 3341' w/1000 sks of
 Pozmix, this filled back of 5 1/2"
 to 435' of surface.
 6-30-53 - Perforated 4 holes,
 434 to 435 and squeezed 234 sks.
 circulating cement back of 5 1/2"
 casing to cellar floor.

Well Commenced: 6-11-53
 Well Completed: 6-28-53

Contractor: E. K. Carey Contractor, Rig #2, Box 620, McPherson, Kansas
 Geologist: Don Hollar, E. K. Carey Drlg. Co. 815 Central Bldg. Wichita

Figures Indicate Bottom of Formation K. B.

Cellar	7	Geologist Tops:	
Shale	25	Lansing	2005
Sand	35	Mississippi	2613
Shale	110	Bs. "	2880
Anhydrite	140	Mise.	2970
Lime	325	Hunton	2974
Lime & shale	920	Maquoketa Shale	3070
Shale & lime	1520	Viola	3170
Lime & shale	1653	Simpson Shale	3250
Lime	1827	Simpson sand	3266
Sand	1834	Arbuckle	3328
Shale & lime	1910	Rotary Total Depth	3669
Shale	2005		
Lime	2292	DST - 2622, Tool open 1 hr. 15 min.	
Lime & shale	2435	20 min. BHP 600#, FFP 15#, recovered	
Shale & lime	2510	55' of water cut drilling mud.	
Lime & shale	2585	Centralizers - 3050, 3000, 2850, 2750,	
Shale	2613	2650, 2250, 2150 and 2050.	
Lime	2870	NOTE: Well given up as a dry hole	
Lime & shale	2895	at 2631' @ 9:08 A.M., 6-20-53. At	
Shale & lime	2985	that time and depth started drilling	
Lime	3095	to Arbuckle for S. W. D. well.	
Shale & lime	3180		
Lime	3669 TD		

This is to certify that the above information is to the best of my knowledge true and correct.

SUBSCRIBED AND SWORN to before me this 30th day of June, 1953

E. K. CAREY CONTRACTOR
 BY Herbert Rhoton
 Herbert Rhoton, Superintendent

Don Hollar
 NP

My Commission Expires: November 13, 1956.