

STATE OF KANSAS  
STATE CORPORATION COMMISSION


Form CP-4

Give All Information Completely  
Make Required Affidavit  
Mail or Deliver Report to:  
Conservation Division  
State Corporation Commission  
P. O. Box 17027  
Wichita, Kansas 67217  
NORTH

WELL PLUGGING RECORD

Saline County, Sec. 33 Twp. 16 Rge. 1 (E) (W)

Location as "NE/CNW/SW" or footage from lines. C N/2 NW NW  
Lease Owner Tomlinson Oil Co., Inc.  
Lease Name Stein #3 Well No. \_\_\_\_\_  
Office Address Wichita, Kansas 67202  
Character of Well (completed as Oil, Gas or Dry Hole) \_\_\_\_\_  
Date well completed \_\_\_\_\_ 19\_\_\_\_  
Application for plugging filed \_\_\_\_\_ 19\_\_\_\_  
Application for plugging approved \_\_\_\_\_ 19\_\_\_\_  
Plugging commenced 2/25/72 \_\_\_\_\_ 19\_\_\_\_  
Plugging completed 3/1/72 \_\_\_\_\_ 19\_\_\_\_  
Reason for abandonment of well or producing formation depleted.

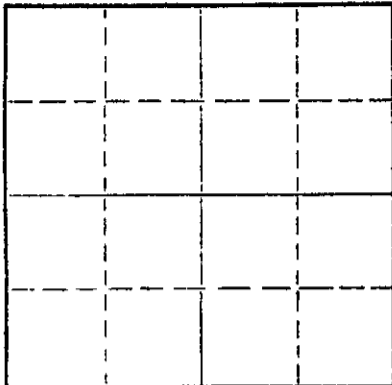

Locate well correctly on above Section Plat

If a producing well is abandoned, date of last production \_\_\_\_\_ 19\_\_\_\_  
Was permission obtained from the Conservation Division or its agents before plugging was commenced? yes

Name of Conservation Agent who supervised plugging of this well Truan  
Producing formation \_\_\_\_\_ Depth to top \_\_\_\_\_ Bottom \_\_\_\_\_ Total Depth of Well 2604 Feet  
Show depth and thickness of all water, oil and gas formations.

OIL, GAS OR WATER RECORDS

CASING RECORD

FORMATION	CONTENT	FROM	TO	SIZE	PUT IN	PULLED OUT
				8-5/8	120	none
				4 1/2"	2593 1/8	1673

Describe in detail the manner in which the well was plugged, indicating where the mud fluid was placed and the method or methods used in introducing it into the hole. If cement or other plugs were used, state the character of same and depth placed, from \_\_\_\_\_ feet to \_\_\_\_\_ feet for each plug set.

Checked bottom, ran sand to 2575', dumped 4 sacks of cement.  
Shot pipe at 2138', mud came in up to 1707', shot pipe at 1696',  
pulled 62 joints. Set 10' rock bridge at 160' and dumped 35 sacks  
of cement. Mud to 40', 10' rock bridge and dumped 10 sacks of  
cement. Tallied pipe.

PLUGGING COMPLETE.

RECEIVED  
STATE CORPORATION COMMISSION  
APR 11 1972  
CONSERVATION DIVISION  
Wichita, Kansas

(If additional description is necessary, use BACK of this sheet)  
Name of Plugging Contractor KNIGHT CASING PULLING CO., INC.  
Address CHASE, KANSAS

STATE OF KANSAS COUNTY OF RICE, ss.  
NOEL J. KNIGHT (employee of owner) or (owner or operator) of the above-described well, being first duly sworn on oath, says: That I have knowledge of the facts, statements, and matters herein contained and the log of the above-described well as filed and that the same are true and correct. So help me God.

(Signature) Noel Knight  
CHASE, KANSAS

SUBSCRIBED AND SWORN to before me this 7th day of March 19 72

Margaret Melcher  
Notary Public.

My commission expires



MARGARET MELCHER  
NOTARY PUBLIC  
Rice County, Kansas  
My Commission Expires  
Feb. 15, 1975

ROTARY DRILLER'S LOG

15169005500000

E. K. Carey Drilling Co., Inc., Operator  
 Box 620  
 McPherson, Kansas

Elevation: 1277 K. B.  
 1275 D. F.  
 1272 Gr.

Stein #3

8-5/8" x 4 1/2" Head 6.60'  
 below K. B.

C, N/2 NW NW/4  
 Sec. 33-16S-1W  
 Saline County, Kansas

Casing Record:  
 8-5/8" Csg. 120' W/85 sx.  
 4-1/2" Csg. 2593 1/2' W/75 sx.

Well Commenced: 10-31-52  
 Well Completed: 11- 8-52

Contractor: E. K. Carey Contractor, Rig #2, Box 620, McPherson, Kansas  
 Geologist: Don Holler, E. K. Carey Drlg. Co. 815 Central Bldg. Wichita

Figures Indicate Bottom of Formation K. B.

Cellar	7
Shale	20
Sand	25
Shale & shells	110
Anhydrite	116
Anhydrite	170
Lime & shale	795
Shale & lime	900
Shale & shells	1480
Lime & shale	1808
Shale & lime	1902
Shale & shells	1990
Lime	2330
Shale & lime	2530
Shale	2592
Lime (Miss)	2595 TD

Geologist Tops;

Lansing 1990  
 Mississippi 2592 (-1315)  
 Rotary Total Depth 2595

Set 4 1/2" casing 2593 1/2' or  
 1/2 feet off bottom.

Cable Tool TD 2604'

RECEIVED  
 STATE CORPORATION COMMISSION  
 FEB 22 1972  
 CONSERVATION DIVISION  
 Wichita, Kansas

The above Rotary Driller's Log is complete and correct to the best of my knowledge.

E. K. CAREY CONTRACTOR

By Herbert Rhoton  
 Herbert Rhoton, Superintendent