


WELL PLUGGING RECORD

Give All Information Completely
Make Required Affidavit
Mail or Deliver Report to:
Conservation Division
State Corporation Commission
212 No. Market
Wichita, Kansas

NORTH

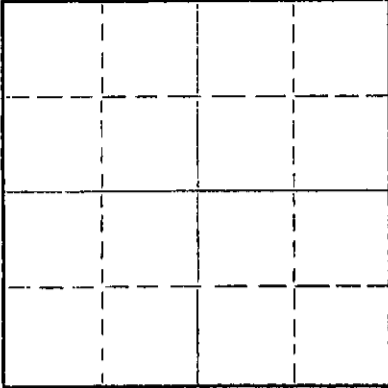

Locate well correctly on above
Section Plat

Saline County, Sec. 33, Twp. 16 Rge. 1 (E) W (W)
Location as "NE/CNW/SW" or footage from lines E SW SW SW
Lease Owner Hollar Oil Co.
Lease Name Stein Well No. 4
Office Address P. O. Box 620, McPherson, Kans. 67460
Character of Well (completed as Oil, Gas or Dry Hole) Oil
Date well completed 19
Application for plugging filed August 4 19 69
Application for plugging approved August 5 19 69
Plugging commenced August 19 19 69
Plugging completed August 21 19 69
Reason for abandonment of well or producing formation

If a producing well is abandoned, date of last production 19
Was permission obtained from the Conservation Division or its agents before plugging was commenced? Yes

Name of Conservation Agent who supervised plugging of this well Gilbert Toman
Producing formation MISS CAN T Depth to top Bottom Total Depth of Well 2599 Feet
Show depth and thickness of all water, oil and gas formations.

OIL, GAS OR WATER RECORDS

CASING RECORD

| FORMATION | CONTENT | FROM | TO | SIZE | PUT IN | PULLED OUT |
|-----------|---------|------|----|-------|---------|------------|
| | | | | 8 3/8 | 115' | NONE |
| | | | | 5 1/2 | 2597.5' | 507.35' |
| | | | | | | |
| | | | | | | |
| | | | | | | |
| | | | | | | |

Describe in detail the manner in which the well was plugged, indicating where the mud fluid was placed and the method or methods used in introducing it into the hole. If cement or other plugs were used, state the character of same and depth placed, from feet to feet for each plug set.

Sanded back to 2550' and dumped 5 sacks of cement. Shot pipe off at 507.35'. Pulled pipe and mudded hole to 165'. Set 10' rock bridge and finished filling hole with ready mix cement.

RECEIVED
STATE CORPORATION COMMISSION
SEP 12 1969
CONSERVATION DIVISION
Wichita, Kansas

(If additional description is necessary, use BACK of this sheet)

Name of Plugging Contractor Bert Self
Address Hutchinson, Kans.

STATE OF Kans., COUNTY OF Reno, ss.
Employee (employee of owner) or (owner or operator) of the above-described

well, being first duly sworn on oath, says: That I have knowledge of the facts, statements, and matters herein contained and the log of the above-described well as filed and that the same are true and correct. So help me God.


(Signature) Bert Self

R. R. #1, Hutchinson, Kans. (Address)

Sworn to before me this 27th day of August, 1969

October 18, 1969

Notary Public.

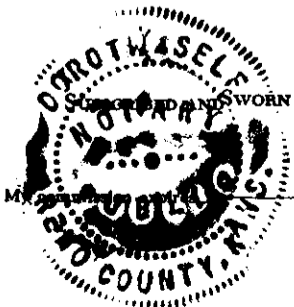

ROTARY DRILLER'S LOG

15-169-00/27-0000

E. K. Carey Drilling Co., Inc., Operator
 Box 620
 McPherson, Kansas

Elevations: 1279 K. B.
 1276 D. F.
 1274 Gr. L.

Stein #4

3-5/8" x 5 1/2" Head 6.60'
 below K. B.

Q, SW SW NW/4
 Sec. 33-153-1W
 Saline County, Kansas

RECEIVED
 STATE CORPORATION COMMISSION
 AUG 12 1969
 CONSERVATION DIVISION
 Wichita, Kansas

Casing Record:
 3-5/8" 115' w/30 ex.
 5-1/2" 2597 1/2' w/50 ex.

Well Commenced: 1-6-53
 Well Completed: 1-14-53

Contractor: E. K. Carey, Contractor, Rig #2, Box 620, McPherson, Kansas
 Geologist: Don Hollar, E. K. Carey Drig. Co. 816 Central Bldg. Wichita

Figures indicate Bottom of Formation K. B.

| | |
|----------------|----------|
| Cellar base | 7 |
| Shale | 40 |
| Shale & shells | 65 |
| Lime & shale | 380 |
| Lime | 505 |
| Lime & shale | 845 |
| Shale & lime | 1480 |
| Lime & shale | 1560 |
| Lime | 1800 |
| Lime & shale | 1850 |
| Shale & lime | 2000 |
| Lime K. C. | 2095 |
| Lime | 2520 |
| Lime & shale | 2545 |
| Shale | 2593 1/2 |
| Miss. lime | 2599 TD |

Geologist Tops:

Lansing 2000
 Mississippi 2596 1/2 (-1317 1/2)

Rotary Total Depth 2599

Set 5 1/2" @ 2597 1/2, or 1-1/2 foot
 off bottom.

This is to certify that the above information is to the best of my
 knowledge true and correct.

SUBSCRIBED AND SWORN to before me this 14th day of January, 1953.

E. K. CAREY, CONTRACTOR

BY Herbert Rhoton
 Herbert Rhoton, Superintendent

[Signature]
 NP

My Commission Expires: November 13, 1956