


WELL PLUGGING RECORD

Give All Information Completely
Make Required Affidavit
Mail or Deliver Report to:
Conservation Division
State Corporation Commission
800 Bitting Building
Wichita, Kansas

Saline County, Sec. 33 Twp. 16 Rge. (E) 1 (W)

Location as "NE/CNW&SW" or footage from lines NW SW SE/4
Lease Owner Nicholas Chapro
Lease Name Woods Well No. 1
Office Address 815 N. Roxbury Drive, Beverly Hills, Cal.
Character of Well (completed as Oil, Gas or Dry Hole) Dry
Date well completed June 29, 1955 19
Application for plugging filed June 29, " 19
Application for plugging approved June 29, " 19
Plugging commenced 6 P.M. June 29, " 19
Plugging completed 7:30 P.M. June 29, " 19
Reason for abandonment of well or producing formation Non Productive

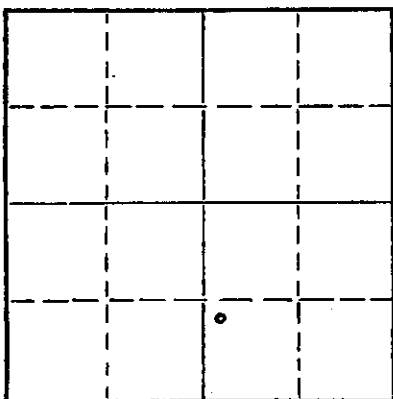

Locate well correctly on above Section Plat

If a producing well is abandoned, date of last production _____ 19____
Was permission obtained from the Conservation Division or its agents before plugging was commenced? Yes

Name of Conservation Agent who supervised plugging of this well Rural Durkee, McPherson, Kansas
Producing formation _____ Depth to top _____ Bottom _____ Total Depth of Well 2664 Feet
Show depth and thickness of all water, oil and gas formations.

OIL, GAS OR WATER RECORDS

CASING RECORD

FORMATION	CONTENT	FROM	TO	SIZE	PUT IN	PULLED OUT
				8-5/8	126'	None

Describe in detail the manner in which the well was plugged, indicating where the mud fluid was placed and the method or methods used in introducing it into the hole. If cement or other plugs were used, state the character of same and depth placed, from 126-96 feet to 25-10 feet for each plug set.

Circulated heavy mud on bottom, layed down half of drill pipe circulated heavy mud half way out. Layed down all but 4 joints drill pipe, ran measureing line and filled hole with heavy mud to 126 feet. Made bridge with tree limb and 1/2 half sack hulls and rocks to hold weight of 4 joints of drill pipe. Mixed 15 sacks sacks cement by Halliburton and put through drill pipe. Filled to 25 feet with heavy mud, set plug there and mixed 5 sacks cement by Halliburton and filled to bottom of cellar floor. Thru plugging at 7:30 P.M.

RECEIVED
STATE CORPORATION COMMISSION
JUL 1 - 1955
CONSERVATION DIVISION
Wichita, Kansas

(If additional description is necessary, use BACK of this sheet)
Name of Plugging Contractor E. K. Carey Contractor
Address Box 620, McPherson, Kansas

STATE OF Kansas, COUNTY OF McPherson, ss.
Arland Bruce (employee of owner) or (owner or operator) of the above-described well, being first duly sworn on oath, says: That I have knowledge of the facts, statements, and matters herein contained and the log of the above-described well as filed and that the same are true and correct. So help me God.

(Signature) Arland Bruce
Box 620, McPherson, Kansas
(Address)

SUBSCRIBED AND SWORN TO before me this 30th day of June 1, 1955

My commission expires November 13, 1956 _____
Notary Public.

PLUGGING
RMC SEC. 33 T. 16 R. 1W
BOOK PAGE 131 LINE 15

ROTARY DRILLER'S LOG

15169-00062-0000

Nicholas Chapiro
815 N. Roxbury Drive
Beverly Hills, California

Elevations: 1279 K.F.

Woods #1

Casing Record:

NW SW SE/4
Sec. 33-16-1W
Saline County, Kansas

8-5/8" O 126' w/25 sks.
Regular cement and 100% cc.

Well Commenced: 6-22-55
Well Completed: 6-29-55 (D & A)

Contractor: E. K. Carey Contractor, Rig #2, Box 620, McPherson, Kansas
Geologist: Willis D. Waterman, 672 S. 9th. St. Salina, Kansas

Figures Indicate Bottom of Formations K. F.

Base and cellar	7
Sand	30
Shale	124
Shells	126
Lime	355
Lime and shale	760
Lime	925
Shale and lime	1300
Lime	1785
Lime and shale	1870
Sand and shale	1915
Shale	2017
K. C. lime	2165
Lime and shale	2250
Lime	2320
Lime and shale	2345
Shale and lime	2648
Lime	2655
Miss. chat	2664 TD

Geologist Tops:

Lansing	2017 (- 733)
Miss. Chat	2648 (-1360)
Rotary Total Depth	2664 (-1325)

D & A June 29, 1955

RECEIVED
COMMISSION
JUL 1 - 1955
MINING DIVISION
Salina, Kansas

This is to certify that the above information is to the best of my knowledge true and correct.

SUBSCRIBED AND SWORN to before me this 30th day of June, 1955

E. K. CAREY CONTRACTOR

BY Herbert Rhoton
Herbert Rhoton, Superintendent

W. D. Waterman
EP

My Commission Expires: November 13, 1956

PLUGGING
FILE SEC 33-16-1W
BOOK PAGE 131 LINE 15