


Give All Information Completely
Make Required Affidavit
Mail or Deliver Report to:
Conservation Division
State Corporation Commission
212 No. Market
Wichita, Kansas

WELL PLUGGING RECORD

NORTH

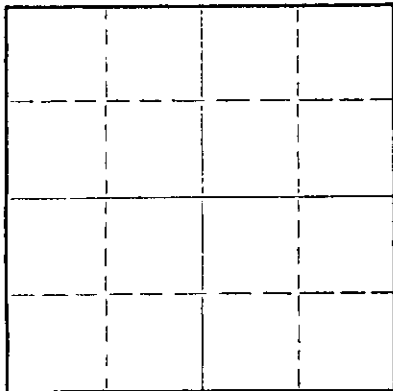

Locate well correctly on above
Section Plat

Saline County. Sec. 32 Twp. 16 Rge. 1W (W) (W)
Location as "NE/CNW/SW" or footage from lines SE NE NE
Lease Owner E. K. Carey Drilling Company
Lease Name Anderson Well No. 1
Office Address P. O. Box 620 McPherson, Kansas
Character of Well (completed as Oil, Gas or Dry Hole) depleted-Oil
Date well completed August 25, 1952
Application for plugging filed December 6, 1961
Application for plugging approved December 6, 1961
Plugging commenced February 5, 1962
Plugging completed February 5, 1962
Reason for abandonment of well or producing formation

If a producing well is abandoned, date of last production 19
Was permission obtained from the Conservation Division or its agents before plugging was commenced? yes

Name of Conservation Agent who supervised plugging of this well Cecil M. Jones
Producing formation Depth to top Bottom Total Depth of Well 2618 Feet
Show depth and thickness of all water, oil and gas formations.

OIL, GAS OR WATER RECORDS

CASING RECORD

FORMATION	CONTENT	FROM	TO	SIZE	PUT IN	PULLED OUT

Describe in detail the manner in which the well was plugged, indicating where the mud fluid was placed and the method or methods used in introducing it into the hole. If cement or other plugs were used, state the character of same and depth placed, from feet to feet for each plug set.

Filled hole with sand from T.D. 2618' back to 2605' ran 5 sacks cement with dump bailer. Shot off and pulled 5 1/2" casing. Filled hole with mud from 2585' back to 150' set a 10' rock bridge and ran 25 sacks cement. Filled hole with mud from 75' back to 35' set a bridge and 8 sacks cement back to zero. 4' below ground level. 8 5/8" surface pipe 4' below ground level.

RECEIVED
OCT 10 1966
CONSERVATION DIVISION
STATE CORPORATION COMMISSION

(If additional description is necessary, use BACK of this sheet)
Name of Plugging Contractor Bert Self Casing Pulling Company
Address R. R. # 4 Hutchinson, Kansas

STATE OF _____, COUNTY OF _____, ss.

(employee of owner) or (owner or operator) of the above-described well, being first duly sworn on oath, says: That I have knowledge of the facts, statements, and matters herein contained and the log of the above-described well as filed and that the same are true and correct. So help me God.

(Signature) X Bert Self
(Address)

SUBSCRIBED AND SWORN to before me this _____ day of _____ 1969

My commission expires October 18, 1969 _____ Notary Public.

14
 ROTARY DRILLER'S LOG 15.169.00018.0000

E. K. Carey Drilling Co., Inc. - Operator
 Box 620
 McPherson, Kansas

1290 K. B.
 Elevation: 1287 D. F.
 1284 Gr.

R. M. Anderson #1
 C, SE/4 NE/4 NE/4
 Sec. 32-16S-1W
 Saline County, Kansas

3-5/8" x 4 1/2" Head 6.90'
 below K. B.

Casing Record:

3-5/8" Csg. 124' w/80 sx.
 4-1/2" Csg 2613' w/75 sx.
 Cemented 2' off bottom.

Well Commenced: 8-17-52
 Well Completed: 8-25-52

Contractor: E. K. Carey Contractor, Rig #2, Box 620, McPherson, Kansas
 Geologist: Don Hollar, E. K. Carey Drlg. Co., 815 Central Bldg. Wichita

Figures Indicate Bottom of Formation K. B.

Cellar	7
Shale	25
Shells & shale	100
Shale & shells	124
Anhydrite	276
Lime & shale	605
Shale, lime & red bed	640
Lime & shale	825
Shale & lime	1500
Lime & shale	1820
Shale & lime	1880
Shale & shells	1998
K. C. Lime	2005
Lime	2185
Lime & shale	2370
Shale & lime	2606
Mississippi lime	2612
Mississippi chat	2615 TD

Geologist Tops:

Lansing	2006
Miss. Lime	2606 (-1316)
Miss. Chert	2612

Rotary TD 2615

Set 4 1/2" casing 2613, 2' off bottom.

RECEIVED
 STATE CORPORATION COMMISSION

FEB 23 1962

CONSERVATION DIVISION
 WICHITA, KANSAS

The above Rotary Driller's Log is complete and correct to the best of my knowledge.

E. K. CAREY CONTRACTOR

By Herbert Rhoton
 Herbert Rhoton, Superintendent