


WELL PLUGGING RECORD

Give All Information Completely  
Make Required Affidavit  
Mail or Deliver Report to:  
Conservation Division  
State Corporation Commission  
800 Biting Building  
Wichita, Kansas

Saline County, Sec. 32 Twp. 16 Rge. (E) 1 (W)

Location as "NE/CNW/SW" or footage from lines SW NE SE  
Lease Owner Westgate-Greenland Oil Company  
Lease Name Lucy Van Meter Well No. 2  
Office Address 1009 Central Building, Wichita 2, Kansas  
Character of Well (completed as Oil, Gas or Dry Hole) dry hole  
Date well completed January 21, 1953 19  
Application for plugging filed April 23, 1953 19  
Application for plugging approved April 24, 1953 19  
Plugging commenced May 18, 1953 19  
Plugging completed May 30, 1953 19  
Reason for abandonment of well or producing formation \_\_\_\_\_

NORTH

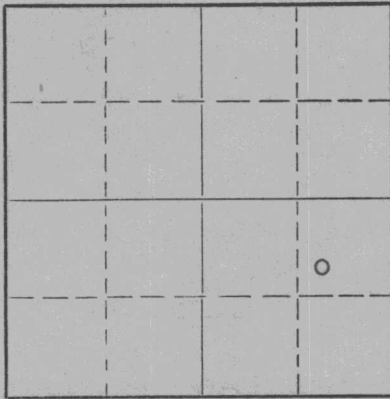

Locate well correctly on above Section Plat

If a producing well is abandoned, date of last production \_\_\_\_\_ 19  
Was permission obtained from the Conservation Division or its agents before plugging was commenced? yes

Name of Conservation Agent who supervised plugging of this well Ruel Durkee  
Producing formation \_\_\_\_\_ Depth to top \_\_\_\_\_ Bottom \_\_\_\_\_ Total Depth of Well \_\_\_\_\_ Feet  
Show depth and thickness of all water, oil and gas formations.

OIL, GAS OR WATER RECORDS

CASING RECORD

FORMATION	CONTENT	FROM	TO	SIZE	PUT IN	PULLED OUT
Surface		0	137	10 3/4"	137	none
Mississippi		0	2643	7"	2643	2147 feet

Describe in detail the manner in which the well was plugged, indicating where the mud fluid was placed and the method or methods used in introducing it into the hole. If cement or other plugs were used, state the character of same and depth placed, from \_\_\_\_\_ feet to \_\_\_\_\_ feet for each plug set.

Filled hole with crushed rock from TD to 2635 feet  
Ran 6 sacks cement from 2635 to 2600 feet  
Filled with heavy mud from 2600 to 135 feet and  
made solid with rock, ran 15 sacks cement from 135 to 100 feet  
Filled with heavy mud from 100 to 15 feet and rock to 10 feet  
Capped with 5 sacks cement from 10 feet to cellar.

(If additional description is necessary, use BACK of this sheet)

Name of Plugging Contractor Morgan Well Plugging Service  
Address 102 West 18th Street, Hutchinson, Kansas

STATE OF Kansas, COUNTY OF Sedgwick, ss.  
Harold A. Burt (employee of owner) or ~~owner or operator~~ of the above-described well, being first duly sworn on oath, says: That I have knowledge of the facts, statements, and matters herein contained and the log of the above-described well as filed and that the same are true and correct. So help me God.

(Signature) Harold A. Burt  
1009 Central Building, Wichita, Kansas  
(Address)

SUBSCRIBED AND SWORN TO before me this 6th day of June, 1953.

My commission expires May 25, 1957

RECEIVED  
STATE CORPORATION Notary Public.

JUN 6 1953

CONSERVATION DIVISION  
Wichita, Kansas

**PLUGGING**  
FILE SEC 32 T 16 R 14  
BOOK PAGE 95 LINE 36

## DRILLERS LOG

COMPANY: Westgate-Greenland Oil Company  
 FARM: Lucy VanMeter #2, SW NE SE 32-16-1W  
 Saline County, Ks  
 CONTRACTOR: Westgate Drilling Corporation  
 COMMENCED: January 3, 1953 - Rotary  
 January 13, 1953 - Cardwell  
 COMPLETED: January 11, 1953 - Rotary  
 January 21, 1953 - Cardwell  
 ELEVATION: 1294 DF

0	to	40	Clay and sand
40	to	80	Shale and shells
80	to	130	Shale
130	to	145	Shale and shells
145	to	520	Lime W/shale breaks
520	to	710	Lime and shale
710	to	1530	Shale and shells
1530	to	1685	Shale and lime
1685	to	1740	Lime W/shale breaks
1740	to	2050	Lime and shale
2050	to	2113	Lime
2113	to	2600	Lime and shale
2600	to	2610	Shale
2610	to	2652	(T. D) Miss Lime & Chert
2652	to	2652	T. D. (RB)
2652	to	2697	Cardwell

RECEIVED  
 STATE CORPORATION COMMISSION  
 APR 24 1953  
 CONSERVATION DIVISION  
 Wichita, Kansas

Set 137' of 10 3/4" 32# Surface pipe. Cemented with 110 Cement and 2 sacks calcium chloride.

Set 7" casing at 2643 (DF). Cemented with 75 sacks cement.

TOPS: Iatan 1970                      Mississippi 2607  
 Lansing 2021                      Mississippi Dolomite 2643

Drill Stem Test: 2643-49, open 1/2 hours, weak blow  
 6 minutes, rec. 10' mud, BHP 665#.

no sdumberger run.

Drilled 5 feet new hole with Cardwell, 500 GA, scum oil, no water, drilled to 2677, light show oil & some water. Drilled to 2697, 2 1/2 BWPB with light show oil.

DRY AND ABANDONED

## C E R T I F I C A T E

I, G. E. Bitler, do hereby certify that the above and foregoing is a true and correct copy of the log of the Lucy VanMeter #2, SW NE SE 32-16-1W, Saline County, Kansas, as reflected by files of the Westgate-Greenland Oil Company

*G. E. Bitler*  
 G. E. Bitler

Subscribed and sworn to before me, a Notary Public, within and for Sedgwick County, Kansas, this 23rd day of April 23, 1953

*Esther Unsell*  
 Esther Unsell, Notary Public

My Commission expires May 25, 1953.

