


WELL PLUGGING RECORD

Give All Information Completely
Make Required Affidavit
Mail or Deliver Report to:
Conservation Division
State Corporation Commission
800 Bittling Building
Wichita, Kansas

Saline County, Sec. 32 Twp. 16 Rge. 1W (E) (W)
SE SW SE

NORTH

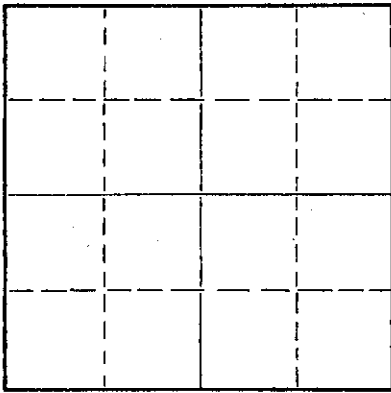

Locate well correctly on above
Section Plat

Location as "NE/CNW/SW" or footage from lines _____
Lease Owner Morgenstern & Specter
Lease Name Lucy Van Meter Well No. 4
Office Address Box 661, Russell, Kansas
Character of Well (completed as Oil, Gas or Dry Hole) ~~Producing~~ Dry hole
Date well completed 8/16/56 _____
Application for plugging filed October 10 _____
Application for plugging approved " _____
Plugging commenced 10/21/56 _____
Plugging completed 10/24/56 _____
Reason for abandonment of well or producing formation Dry hole

If a producing well is abandoned, date of last production _____
Was permission obtained from the Conservation Division or its agents before plugging was commenced? Yes

Name of Conservation Agent who supervised plugging of this well Ruel Durkee
Producing formation Mississippi chat Depth to top 2645 Bottom 2651 Total Depth of Well 2656 Feet
Show depth and thickness of all water, oil and gas formations.

OIL, GAS OR WATER RECORDS

CASING RECORD

FORMATION	CONTENT	FROM	TO	SIZE	PUT IN	PULLED OUT
				10 3/4"	159'	none
				6 5/8"	2652'	2295'

Describe in detail the manner in which the well was plugged, indicating where the mud fluid was placed and the method or methods used in introducing it into the hole. If cement or other plugs were used, state the character of same and depth placed, from _____ feet to _____ feet for each plug set.

Fill hole with sand to 2645'
Dump 6 sacks of cement
Mud hole to 160'
Put in 10' rock bridge
Mix and run 20 sacks of cement
Mud to top, rock bridge
5 sacks cement to top of cellar

(If additional description is necessary, use BACK of this sheet)

Name of Plugging Contractor Arnett Casing Pulling Company
Address Hoisington, Kansas

STATE OF Kansas, COUNTY OF Russell, ss.
Arthur Morgenstern

(owner or operator) or (owner or operator) of the above-described well, being first duly sworn on oath, says: That I have knowledge of the facts, statements, and matters herein contained and the log of the above-described well as filed and that the same are true and correct. So help me God.

(Signature) Arthur Morgenstern
Box 661, Russell, Kansas
(Address)

SUBSCRIBED AND SWORN to before me this 1st day of Nov., 1956

My commission expires April 14 - 1959

W. Schmidt 11-03-56
Notary Public.

PLUGGING
FILE SEC. 32 T. 16 R. 1W
BOOK PAGE 105 LINE 6

15169.006 65.0000

WELL LOG BUREAU—KANSAS GEOLOGICAL SOCIETY
508 East Murdock, Wichita, Kansas


Company- NATURAL GAS & OIL
Farm- Lucy Van Meter No. 4

SEC. 32 T. 16 R. 1W
SE SW SE

Total Depth. 2661'
Comm. 8-7-56 Comp. 8-16-56
Shot or Treated.
Contractor. Greenland Drlg. Co.
Issued. 10-6-56

County Saline

KANSAS

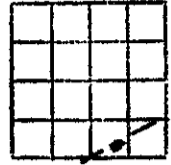

Elevation. 1330' RB

Production. Dry

Figures indicate Bottom of Formations.

clay-sand	70
shale-shells	110
lime-shale	200
lime	250
lime-shale	320
shale-lime w/red bed stks	375
lime-shale	1685
shale	1695
lime-shale	1843
sand-shale-shells	1954
shale-lime	2052
lime	2132
lime-shale	2649
lime-chert	2655
chart	2661
Total Depth	RTD

TOPS: Scout	
Heebner	1851
Toronto	1858
Douglas sand	1897
Ioton	1994
Lansing	2052
Mississippi lime	2645
Mississippi chat	2651
Mississippi Dolomite	2656

PLUGGING
FILE SEC 32 T. 16 R. 1W
BOOK PAGE 105 LINE 6

RECEIVED
NOV - 7 1956
CONSERVATION DIVISION
Wichita, Kansas