


WELL PLUGGING RECORD

Give All Information Completely
Make Required Affidavit
Mail or Deliver Report to:
Conservation Division
State Corporation Commission
800 Bittling Building
Wichita, Kansas

NORTH

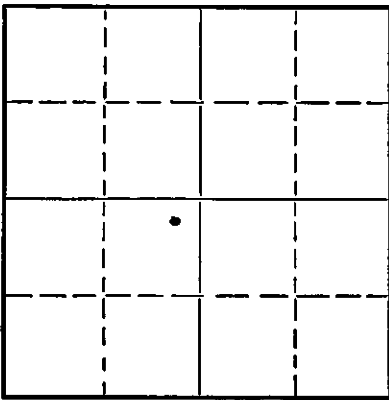

Locate well correctly on above
Section Plat

Saline County. Sec. 11 Twp. 16 Rge. 4 (E) 4 (W)
Location as "NE/CNW $\frac{1}{4}$ SW $\frac{1}{4}$ " or footage from lines
Lease Owner Franco Central Oil Co.
Lease Name Bloomquist Well No. 1
Office Address Fourth National Bank Bldg. Wichita, Ks.
Character of Well (completed as Oil, Gas or Dry Hole)
Date well completed 3-16 19 51
Application for plugging filed 19
Application for plugging approved 19
Plugging commenced 3-19 19 51
Plugging completed 3-23 19 51
Reason for abandonment of well or producing formation no oil
If a producing well is abandoned, date of last production 19
Was permission obtained from the Conservation Division or its agents before plugging was commenced?

Name of Conservation Agent who supervised plugging of this well R. Durkee
Producing formation Depth to top Bottom Total Depth of Well 3520 Feet
Show depth and thickness of all water, oil and gas formations. 3641

OIL, GAS OR WATER RECORDS

CASING RECORD

Formation	Content	From	To	Size	Put In	Pulled Out

Describe in detail the manner in which the well was plugged, indicating where the mud fluid was placed and the method or methods used in introducing it into the hole. If cement or other plugs were used, state the character of same and depth placed, from feet to feet for each plug set.

Set Baker plug at 3520' and 3480'. Filled with sand to 3450' and dumped cement (6sax). Mudded hole to 175' and put in rock bridge and 15 sax cement. Filled with muc and dump 5 sax cement on top.

RECEIVED
STATE CORPORATION COMMISSION

APR - 6 1951

CONSERVATION DIVISION

(If additional description is necessary, use BACK of this sheet)

Correspondence regarding this well should be addressed to Franco Central Oil Co. Wichita, Kansas
Address Fourth National Bank Building - Wichita, Kansas

STATE OF Kansas, COUNTY OF ~~Harvey~~ Sedgwick, ss.
(employee of owner) or (owner or operator) of the above-described well,
being first duly sworn on oath, says: That I have knowledge of the facts, statements, and matters herein contained and the log of the above-described well as filed and that the same are true and correct. So help me God.

(Signature) *A. McClothru*
306 Fourth National Bank Building
(Address)

SUBSCRIBED AND SWORN to before me this 5th day of April, 19 51
Mary C. Gruebel
Notary Public.

My commission expires 9-25-54

PLUGGING
FILE SEC 11 T 16 R 4 W
BOOK PAGE 67 LINE 45

15169-00090-0000

Company: Penguin Petroleum Company
Farm: Blomquist #1

Sec 11, T 16, R 4W
NE NE SW
Saline County, Kansas
Rotary Tools
Elevation: 1334'
Rotary Total Depth: 3641'

Comm: February 22, 1951
Comp: March 9, 1951
Contractor: J. A. Melland

Casing: 5 1/2" @ 3600' Com. w/50 ex.
8 5/8" @ 237'

0-225	Cement
-310	Shale & lime
-480	Shale & lime
-535	Lime & shale
-585	Shale
-1060	Lime & shale
-1725	Shale & lime
-1795	Lime & shale
-2105	Lime
-2200	Lime & shale
-2260	Shale
-2300	Shale & lime
-2810	Lime
-2855	Shale & lime
-2900	Lime & shale
-3195	Lime
-3240	Lime & shale
-3300	Shale
-3395	Shale & lime
-3465	Shale
-3550	Lime & shale
-3641	Lime

R.U.S.T. 3641' R.T.D.

Tops:	Lansing	2291'
	Mississippi	2942'
	Kinderhook	3235'
	Maquoketa	3461'
	Viola	3515'
	Simpson	3595'

Drill Stem Test @ 3459 1/2 - 65' - Recovered 20' mud and tr. oil.

Certified to be a true copy of the well log as indicated on daily drilling reports.

PENGUIN PETROLEUM, INC.

By W.G. Tallent

Subscribed and sworn to before me, the undersigned, a Notary Public in and for Sedgwick County, Kansas, this 2 day of April, 1951.

My Commission Expires:

October 13, 1952

E.D. Suckland
Notary Public

RECEIVED
STATE CORPORATION COMMISSION

APR - 6 1951

CONSERVATION DIVISION
Wichita, Kansas

PLUGGING
FILE SEC <u>11</u> T <u>16</u> R <u>4W</u>
BOOK PAGE <u>67</u> LINE <u>45</u>