


WELL PLUGGING RECORD

Give All Information Completely
Make Required Affidavit
Mail or Deliver Report to:
Conservation Division
State Corporation Commission
211 No. Broadway
Wichita, Kansas

NORTH

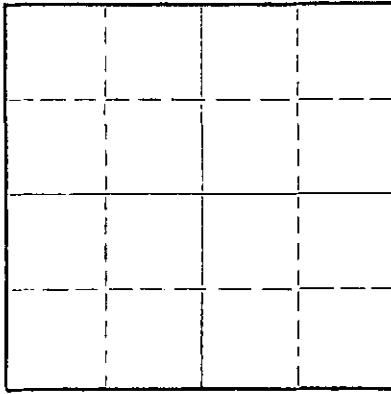

Locate well correctly on above
Section Plat

Saline County. Sec. 11 Twp. 16 Rge. 4 (E) W (W)
Location as "NE/CNW/SW" or footage from lines NE NE NW
Lease Owner Jones, Shelburne & Farmer, Inc.
Lease Name Lagerstrom #1 Well No. _____
Office Address Russell, Kansas
Character of Well (completed as Oil, Gas or Dry Hole) _____
Date well completed _____ 19____
Application for plugging filed _____ 19____
Application for plugging approved _____ 19____
Plugging commenced 10-24-57 _____ 19____
Plugging completed 10-26-57 _____ 19____
Reason for abandonment of well or producing formation _____

If a producing well is abandoned, date of last production _____ 19____
Was permission obtained from the Conservation Division or its agents before plugging was commenced? yes

Name of Conservation Agent who supervised plugging of this well Ruel Durkee
Producing formation _____ Depth to top _____ Bottom _____ Total Depth of Well 3457 Feet
Show depth and thickness of all water, oil and gas formations.

OIL, GAS OR WATER RECORDS

CASING RECORD

FORMATION	CONTENT	FROM	TO	SIZE	PUT IN	PULLED OUT
				8-5/8"	367'	none
				5-1/2"	3856'	2900'

Describe in detail the manner in which the well was plugged, indicating where the mud fluid was placed and the method or methods used in introducing it into the hole. If cement or other plugs were used, state the character of same and depth placed, from _____ feet to _____ feet for each plug set.

Checked the hole to 3457' and found it open.
Filled w/sadn to 3445' and ran 6 sacks of cement. Pulled 5 1/2" casing. Mudded the hole to 210' and set a 10' rock bridge and ran 15 sacks of cement. Mudded the hole to 25', set a 10' rock bridge and ran 5 sacks of cement to base of cellar.

RECEIVED
NOV 11-04-57

(If additional description is necessary, use BACK of this sheet)
Name of Plugging Contractor West Supply Co., Inc.
Address Chase, Kansas

STATE OF Kansas COUNTY OF Russell, ss.
John O. Farmer (employee of owner) or (owner or operator) of the above-described well, being first duly sworn on oath, says: That I have knowledge of the facts, statements, and matters herein contained and the log of the above-described well as filed and that the same are true and correct. So help me God.

(Signature) John O. Farmer

Lucille Farmer (Address)

SUBSCRIBED AND SWORN TO before me this 1st day of November, 1957

My commission expires October 11, 1958

Notary Public.

PLUGGING
FILE SEC 11 T. 16 R. 4W
ROCK PAGE 54 LINE 10

WELL LOG

15.169.00627.0000

Jones, Shelburne & Farmer
Lagerstrom #1

NE NE NW
Sec 11 - Twp 16 - Rge 4
Saline County, Kansas

Total Depth: 3457 Rotary
Commenced: September 3, 1952
Completed: September 17, 1952
Drilled by Shields Drilling Co., Inc.

CASING RECORD

Size	Run	
8 5/8"	367'	Cemented w/ 314 sax
5 1/2"	3456 1/2'	Cemented w/ 75 sax

Elevation: 1343' RB
Treatment:
Production:

	From	To	
Surface Clay & Sand	0	68	
Shale	68	130	
Shale & Shells	130	245	
Anhydrite Lime	245	367	
Lime & Shale	367	570	
Lime, Shale & Sand	570	600	
Shale & Sand	600	740	
Shale	740	875	
Shale & Lime	875	960	
Lime & Shale	960	1060	
Lime, Shale & Salt	1060	1200	
Lime, Shale & Salt	1200	1330	
Shale	1330	1350	
Shale & Lime	1350	1540	
Shale	1540	1720	
Shale & Lime	1720	1855	
Lime & Shale	1855	1920	
Lime & Shale	1920	2045	
Shale & Lime	2045	2155	
Lime & Shale	2155	2265	
Lime & Shale	2265	2350	
Lime & Shale	2350	2455	
Lime & Shale	2455	2530	
Lime & Shale	2530	2610	
Lime & Shale	2610	2670	
Lime & Shale	2670	2735	
Lime & Shale	2735	2800	
Shale	2800	2865	
Lime & Shale	2865	2926	
Shale & Lime	2926	2995	
Lime	2995	3042	
Lime & Shale	3042	3108	
Lime & Shale	3108	3151	
Lime & Shale	3151	3188	
Shale & Lime	3188	3215	
Shale & Lime	3215	3277	
Shale	3277	3342	
Shale	3342	3410	
Shale	3410	3454	
Shale	3454	3456	
Maquoketa Dolomite	3456	3457	TD

TOP OF Maquoketa Dolomite - 3456

RECEIVED
OCT 17 1952
COMMISSION
DIVISION

PLUGGING
FILE SEC 11 T 16 NW
BOOK PAGE 54 LINE 10