


WELL PLUGGING RECORD

Give All Information Completely
Make Required Affidavit
Mail or Deliver Report to:
Conservation Division
State Corporation Commission
800 Bitting Building
Wichita, Kansas

Saline County. Sec. 1 Twp. 16s Rge. 4 (E) (W)
Location as "NE/CNW/SW" or footage from lines NW NW SW
Lease Owner The El Dorado Refining Company
Lease Name Olsson Well No. 1
Office Address Box 209 Russell, Kansas
Character of Well (completed as Oil, Gas or Dry Hole) Oil
Date well completed June 29 19 51
Application for plugging filed April 17 19 56
Application for plugging approved April 18 19 56
Plugging commenced May 8 19 56
Plugging completed May 16 19 56
Reason for abandonment of well or producing formation Insufficient Production

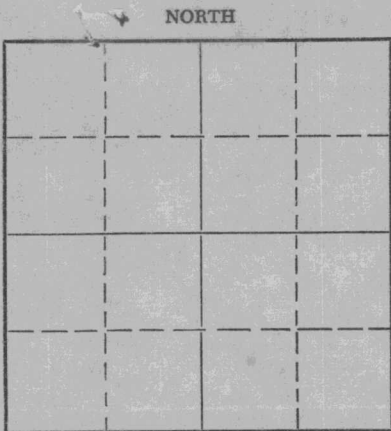

Locate well correctly on above Section Plat

If a producing well is abandoned, date of last production May 1 19 56
Was permission obtained from the Conservation Division or its agents before plugging was commenced? yes

Name of Conservation Agent who supervised plugging of this well Mr. Ruel Durkee-Box 597 - McPherson, Kansas
Producing formation Maquoketa Dolomite Depth to top 3422 Bottom 3422 Total Depth of Well 3426 Feet
Show depth and thickness of all water, oil and gas formations.

OIL, GAS OR WATER RECORDS

CASING RECORD

FORMATION	CONTENT	FROM	TO	SIZE	PUT IN	PULLED OUT
				8 5/8"	342'	None
				5 1/2"	3425'	2924.70'

Describe in detail the manner in which the well was plugged, indicating where the mud fluid was placed and the method or methods used in introducing it into the hole. If cement or other plugs were used, state the character of same and depth placed, from _____ feet to _____ feet for each plug set.

Filled hole with sand to 3415' Run 6 sacks of cement at 3415' Mudded to 190' Set rock bridge to 180' Run 15 sacks of cement at 180' Mudded to 35' Set rock bridge to 30' Run 5 sacks of cement to cap.

(If additional description is necessary, use BACK of this sheet)

Name of Plugging Contractor C. E. Shull Casing Pulling Company
Address Box 558 Great Bend, Kansas

STATE OF KANSAS, COUNTY OF RUSSELL, ss.
LEVI B. SHERMAN (employee of owner) or (owner or operator) of the above-described well, being first duly sworn on oath, says: That I have knowledge of the facts, statements, and matters herein contained and the log of the above-described well as filed and that the same are true and correct. So help me God.

(Signature) Levi B. Sherman
Box 209 Russell, Kansas
(Address)

SUBSCRIBED AND SWORN TO before me this 23rd day of May, 19 56

My commission expires 5-9-59

Carol J. Millinger
Notary Public.

24-7368-5

3-53-20M

RECEIVED
STATE CORPORATION COMMISSION

MAY 24 1956

CONSERVATION DIVISION
Wichita, Kansas

PLUGGING
FILE SEC 1 T 16 R 4w
BOOK PAGE 54 LINE 30

STERLING DRILLING CO.

STERLING, KANSAS

15-169-01003-0000

WELL LOG ----- OLSSON #1

Location: SW/4 of Section 1-16s-4w, Saline County, Kansas

Owner: The El Dorado Refining Company
Rotary Drilling Contractor: Sterling Drilling Company
Cable Tools Contractor: Sterling Drilling Company

Commenced: 5-12-51
Completed: 5-24-51 (w/r)
6-5-51 (w/c.t.)

Total Depth: 3428' (w/r)
3728' (w/c.t.)

ELEVATION: 1314 DF
1312 Gr

LOG

CASING RECORD:

0- 335	Surface Clay and Shale
335- 365	Anhydrite
1356--1050	Lime
1050--1245	Lime and Shale
1245--1800	Shale and Shells
1800--2365	Lime and Shale
2365--2780	Lime
2780--2885	Shale and Lime
2885--3030	Lime
3030--3160	Lime and Chert
3160--3191	Lime
3191--3425	Shale
3425--3728	Lime

342' of 8 5/8" surface Pipe
Cemented with 225 sacks cement.
3425' of 5 1/2" O.D. Casing
Cemented with 50 sacks cement.

CABLE TOOL RECORD: Drilled plug. Cleaned out. Hole filled 800 ft. of oil in 1 hr. After cleaning and swabbing well, it filled up 3400 ft. in 8 hrs. Swab test showed well making 14 bbl. per hr.

(T.D. 3427')

RECEIVED

STATE COMMISSION

MAY 19 1956

CONSERVATION DIVISION

Wichita, Kansas

PLUGGING			
FILE	SEC	T	R
	1	16	4w
BOOK	PAGE	LINE	
	54	30	