


WELL PLUGGING RECORD

Give All Information Completely
Make Required Affidavit
Mail or Deliver Report to:
Conservation Division
State Corporation Commission
211 No. Broadway
Wichita, Kansas

Saline County, Sec. 1 Twp. 16 Rge. 4 (E) W (W)

Location as "NE/CNW/SW" or footage from lines NW NE NW
Lease Owner Phillips and Sanderson
Lease Name R.C. Ryding #3 Well No. _____
Office Address Salina, Kansas
Character of Well (completed as Oil, Gas or Dry Hole) _____
Date well completed _____ 19____
Application for plugging filed _____ 19____
Application for plugging approved _____ 19____
Plugging commenced 10-28-57 _____ 19____
Plugging completed 10-30-57 _____ 19____
Reason for abandonment of well or producing formation _____

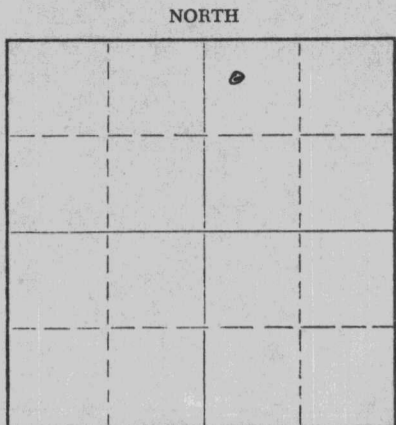

Locate well correctly on above Section Plat

If a producing well is abandoned, date of last production _____ 19____
Was permission obtained from the Conservation Division or its agents before plugging was commenced? yes

Name of Conservation Agent who supervised plugging of this well Ruel Durkee
Producing formation _____ Depth to top _____ Bottom _____ Total Depth of Well 3435 Feet
Show depth and thickness of all water, oil and gas formations.

OIL, GAS OR WATER RECORDS

CASING RECORD

FORMATION	CONTENT	FROM	TO	SIZE	PUT IN	PULLED OUT
				8-5/8"	360'	none
				5-1/2"	3433'	2879'

Describe in detail the manner in which the well was plugged, indicating where the mud fluid was placed and the method or methods used in introducing it into the hole. If cement or other plugs were used, state the character of same and depth placed, from _____ feet to _____ feet for each plug set.

Checked the hole to 3435' and found it open.
Filled w/sand to 3420' and ran 6 sacks of cement.
Pulled 5 1/2" casing. Mudded the hole to 210',
set a 10' rock bridge and ran 15 sacks of cement to 155'. Mudded the hole to 25', set a 10' rock bridge and ran 5 sacks of cement to base of cellar.

RECEIVED
STATE CORPORATION COMMISSION
NOV 14 1957
CONSERVATION DIVISION
Wichita, Kansas

(If additional description is necessary, use BACK of this sheet)

Name of Plugging Contractor West Supply Co., Inc.
Address Chase, Kansas

STATE OF Kansas, COUNTY OF Saline, ss. T.A. Phillips (employee of owner) or (owner or operator) of the above-described well, being first duly sworn on oath, says: That I have knowledge of the facts, statements, and matters herein contained and the log of the above-described well as filed and that the same are true and correct. So help me God.

(Signature) T.A. Phillips
535 Statish Salina Rd
(Address)

SUBSCRIBED AND SWORN TO before me this 13th day of November, 1957
Charlotte Hoyle
Notary Public.

My commission expires July 1, 1959

PLUGGING
FILE SEC. 1 T. 16 R. 4 W
BOOK PAGE 56 LINE 23

W E L L R E C O R D

15.169.00943.0000

LEASE NAME Ryding WELL NO. 3
 LOCATION NW/4 NE/4 NE/4 Section 1-16S-4W, Saline County, Kansas
 WORK COMMENCED February 18, 1952 DRILLING COMMENCED February 20, 1952
 DRILLING COMPLETED March 3, 1952
 ROTARY DRILLING FROM 0' TO 3435'
 DRILLING CONTRACTOR J. A. Melland, 1111 North Main, Hutchinson, Kansas
 WELL OWNER Phillips & Sanderson

FORMATION	FROM	TO	REMARKS
Surface soil	0	15	
Shale and shells	15	220	
Shale	220	250	
Shale and shells	250	290	
Shale	290	300	
Shale and shells	300	355	
Anhydrite	355	360	Set and cemented 8-5/8" OD casing at 360' with 250 sacks of cement.
Anhydrite, shale and shells	360	460	
Lime and shale	460	590	
Red bed	590	622	
Shale and lime	622	755	
Lime and shale	755	890	
Shale and shells	890	920	
Shale and lime	920	1110	
Shale and shells	1110	1560	
Shale	1560	1825	
Shale and shells	1825	1995	
Lime	1995	2270	
Shale and lime	2270	2310	
Lime	2310	2450	
Shale	2450	2505	
Lime and shale	2505	2695	
Shale	2695	2766	
Shale and shells	2766	2890	
Shale and lime	2890	2995	
Lime	2995	3100	
Shale and lime	3100	3107	
Lime	3107	3110	
Lime and chert	3110	3133	
Lime and chat	3133	3181	
Lime	3181	3203	
Shale and shells	3203	3279	
Lime and shale	3279	3360	
Shale and shells	3360	3432	
Lime	3432	3435	
TOTAL DEPTH		3435	Circulated for samples 1 1/2 hours at 3435'. Set and cemented 5 1/2" OD casing at 3433' with 75 sacks of cement. Slope tests were taken at regular intervals and no deflections from vertical were recorded.

RECEIVED
 CONSERVATION COMMISSION
 OCT 24 1957
 CONSERVATION DIVISION
 Wichita, Kansas

PLUGGING
 FILE SEC 1 T 16 R 4W
 BOOK PAGE 56 LINE 23