

Give All Information Completely  
Make Required Affidavit  
Mail or Deliver Report to:  
Conservation Division  
State Corporation Commission  
800 Bitting Building  
Wichita, Kansas

WELL PLUGGING RECORD

Saline

County, Sec. 2 Twp. 16S Rge. 4 (E) W (W)

Location as "NE/CNW/SW" or footage from lines SE NE SW

Lease Owner McPherson Operating Company

Lease Name Kelley Well No. 2

Office Address Box 326, McPherson, Kansas

Character of Well (completed as Oil, Gas or Dry Hole) \_\_\_\_\_

Date well completed \_\_\_\_\_ 19 \_\_\_\_\_

Application for plugging filed \_\_\_\_\_ 4-13 19 54

Application for plugging approved \_\_\_\_\_ 4-14 19 54


Plugging commenced \_\_\_\_\_ 4-20 19 54

Plugging completed \_\_\_\_\_ 4-26 19 54

Reason for abandonment of well or producing formation no production

If a producing well is abandoned, date of last production March 19 54

Was permission obtained from the Conservation Division or its agents before plugging was commenced? yes

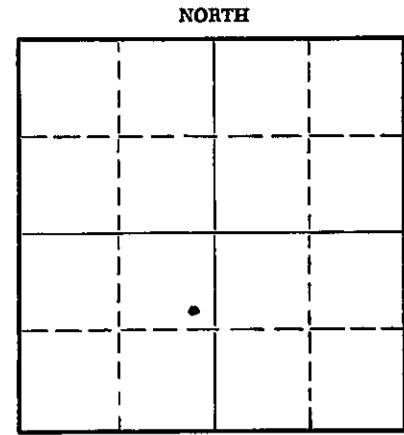

Locate well correctly on above Section Flat

Name of Conservation Agent who supervised plugging of this well Ruel Durkee

Producing formation \_\_\_\_\_ Depth to top \_\_\_\_\_ Bottom \_\_\_\_\_ Total Depth of Well \_\_\_\_\_ Feet

Show depth and thickness of all water, oil and gas formations.

OIL, GAS OR WATER RECORDS

CASING RECORD

FORMATION	CONTENT	FROM	TO	SIZE	PUT IN	PULLED OUT
				8 5/8	375	none
				5 1/8	3601	2981

Describe in detail the manner in which the well was plugged, indicating where the mud fluid was placed and the method or methods used in introducing it into the hole. If cement or other plugs were used, state the character of same and depth placed, from \_\_\_\_\_ feet to \_\_\_\_\_ feet for each plug set.

Total depth 3646' 8 1/2 set at 375' and cemented with 250 sacks circulated to top. 5 1/8 set at 3601 cemented with 75 sacks, Plugged back to 3465. Perforated at 3452 to 3454. Filled back with sand from 3454 to 3445. Dumped 6 sacks cement. Pulled 5 1/8. Mudded. Set bridge at 190'. Bridge was rocked to 180'. Dumped 15 sacks cement and filled with mud to 10' of top. Set bridge and cemented with 5 sacks.

We have no log of this well. Property purchased after well was drilled.

Name of Plugging Contractor The McPherson Oil Company (If additional description is necessary, use BACK of this sheet)  
Address Box 326, McPherson, Kansas

STATE OF Kansas COUNTY OF McPherson, ss.  
J. S. Cling (employee of owner) or (owner or operator) of the above-described

well, being first duly sworn on oath, says: That I have knowledge of the facts, statements, and matters herein contained and the log of the above-described well as filed and that the same are true and correct. So help me God.

(Signature) J. S. Cling Box 326, McPherson, Kansas

SUBSCRIBED AND SWORN TO before me this 27th day of April, 19 54

My commission expires 6-29-57

Eddine E. V. Maloy Notary Public.

24-7568-5 3-53-20M

MAY 5 - 1954

CONSERVATION DIVISION  
Wichita, Kansas

**PLUGGING**  
FILE SEC 2 T 16 R 4W  
BOOK PAGE 27 LINE 2