

STATE OF KANSAS  
STATE CORPORATION COMMISSION

Form CP-4

Give All Information Completely  
Make Required Affidavit  
Mail or Deliver Report to:  
Conservation Division  
State Corporation Commission  
212 No. Market  
Wichita, Kansas

WELL PLUGGING RECORD

Saline County, Sec. 2 Twp. 16 Rge. 4 (E) W (W)

Location as "NE/CNW/SW" or footage from lines E/2 E/2 NE/4

Lease Owner Fender Pipe & Supply, Inc.

Lease Name Lockstrom Well No. 9

Office Address Russell, Kansas

Character of Well (completed as Oil, Gas or Dry Hole) \_\_\_\_\_

Date well completed \_\_\_\_\_ 19\_\_\_\_

Application for plugging filed \_\_\_\_\_ 19\_\_\_\_

Application for plugging approved \_\_\_\_\_ 19\_\_\_\_


Plugging commenced 6-23-66 \_\_\_\_\_ 19\_\_\_\_

Plugging completed ~~6-23-66~~ 6-30-66 \_\_\_\_\_ 19\_\_\_\_

Reason for abandonment of well or producing formation Depleted.

If a producing well is abandoned, date of last production \_\_\_\_\_ 19\_\_\_\_

Was permission obtained from the Conservation Division or its agents before plugging was commenced? yes

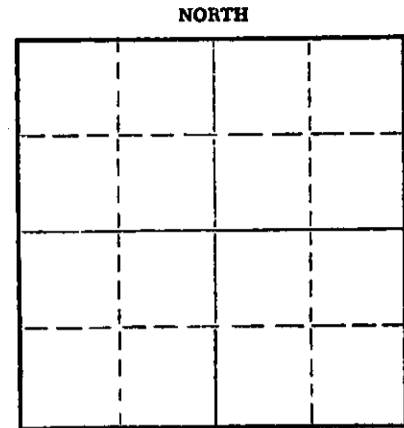

Locate well correctly on above Section Plat

Name of Conservation Agent who supervised plugging of this well Hugh Scott

Producing formation \_\_\_\_\_ Depth to top \_\_\_\_\_ Bottom \_\_\_\_\_ Total Depth of Well 3439 Feet

Show depth and thickness of all water, oil and gas formations.

OIL, GAS OR WATER RECORDS

CASING RECORD

FORMATION	CONTENT	FROM	TO	SIZE	PUT IN	PULLED OUT
				8-5/8"	434'	None
				5-1/2"	3438'	2831'

Describe in detail the manner in which the well was plugged, indicating where the mud fluid was placed and the method or methods used in introducing it into the hole. If cement or other plugs were used, state the character of same and depth placed, from \_\_\_\_\_ feet to \_\_\_\_\_ feet for each plug set.

Checked hole to 3439', sanded hole to 3400' and dumped 5 sacks of cement @ 3400' with dump bailer. Pulled 5 1/2" casing, set rock bridge from 250' to 240' and dumped 20 sacks of cement @ 240'. Mudded hole to 30', set rock bridge and capped well with 10 sacks of cement.

RECEIVED  
STATE CORPORATION COMMISSION

JUL 19 1966

CONSERVATION DIVISION  
Wichita, Kansas

PLUGGING COMPLETE.

(If additional description is necessary, use BACK of this sheet)

Name of Plugging Contractor KNIGHT CASING PULLING COMPANY

Address CHASE, KANSAS

STATE OF KANSAS COUNTY OF RICE, ss.

Noel J. Knight (employee of owner) or (~~owner~~) of the above-described well, being first duly sworn on oath, says: That I have knowledge of the facts, statements, and matters herein contained and the log of the above-described well as filed and that the same are true and correct. So help me God.

(Signature) Noel J. Knight

Chase, Kansas  
(Address)

SUBSCRIBED AND SWORN TO before me this 9th day of July, 19 66

Milton J. Volin  
Notary Public.

My commission expires May 20, 1968

15-169-00266-0000

DEWELLER'S LOG

Company: Derby Oil Company

C-2/2 - 10/2 - 20/2

Sec: 2, Twp: 16, Rge: 4

Farm: Lockstrom Well No: 9  
Total Depth: 3449'

County: Saline,  
Kansas

Comm: 10/18/54 Comp: 10/27/54  
Contractor: Peel Brothers, Inc.

Elevation:

Casing:

8 5/8" @ 437' Com.  
5 1/2" @ 3439' Com.

Production:

Figures below indicate bottom of formation

Clay and shale	0'	70'
Shale and shells		270
Shale and sand streaks		320
Shale and shells		435
Anhydrite		472
Lime		550
Broken lime and shale		630
Sandy shale and shells		1070
Shale and lime streaks		2010
Shale and lime		2925
Shale and cherty lime		3020
Lime and chert		3115
Lime and shale chert		3130
Lime chert and shale streaks		3180
Shale and lime		3280
Shale and lime streaks		3370
Lime		3434
Dolomite		3439
Total Depth		3439

RECEIVED  
STATE CORPORATION COMMISSION  
MAY 6 - 1966  
CONSERVATION DIVISION  
Wichita, Kansas

This is to certify that the above information is to the best of my knowledge true and correct.

PEEL BROTHERS, INC.

BY R. E. Suttors

SUBSCRIBED AND SWORN TO before me this 29 day of October 1954

My commission expires September 28, 1957  
Norma L. Reese  
Notary Public