


Give All Information Completely  
Make Required Affidavit  
Mail or Deliver Report to:  
Conservation Division  
State Corporation Commission  
211 No. Broadway  
Wichita, Kansas

WELL PLUGGING RECORD

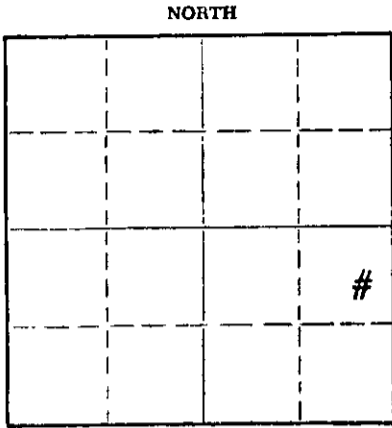

Locate well correctly on above Section Flat

Saline County. Sec. 2 Twp. 16 Rge. 4 (E) W (W)  
Location as "NE/CNW/SW" or footage from lines. SE NE SE  
Lease Owner John O. Farmer Inc.  
Lease Name Sandberg Well No. 3  
Office Address 370 W. Wichita Russell, Ks.  
Character of Well (completed as Oil, Gas or Dry Hole) Oil  
Date well completed June 20, 1952  
Application for plugging filed Dec. 1, 1961  
Application for plugging approved Jan. 8, 1962  
Plugging commenced Jan. 8, 1962  
Plugging completed Jan. 23, 1962  
Reason for abandonment of well or producing formation  
No longer a producer  
If a producing well is abandoned, date of last production 19  
Was permission obtained from the Conservation Division or its agents before plugging was commenced?

Name of Conservation Agent who supervised plugging of this well  
Producing formation Depth to top Bottom Total Depth of Well Feet  
Show depth and thickness of all water, oil and gas formations.

OIL, GAS OR WATER RECORDS				CASING RECORD		
FORMATION	CONTENT	FROM	TO	SIZE	PUT IN	PULLED OUT
				8 5/8	340'	none
				5 1/2	3435'	2852'

Describe in detail the manner in which the well was plugged, indicating where the mud fluid was placed and the method or methods used in introducing it into the hole. If cement or other plugs were used, state the character of same and depth placed, from feet to feet for each plug set.  
Plugged back with sand from 3442' to 3425'. Mixed and dumped 5 ex. cement from 3425' to 3385'. Pulled casing. Mudded to 160'. Set 10' rock bridge from 160' to 150'. Dumped 2 yds. ready mix cement from 150' to base cellar.

RECEIVED  
STATE CORPORATION COMMISSION  
JAN 31 1962  
CONSERVATION DIVISION  
Wichita, Kansas

(If additional description is necessary, use BACK of this sheet)  
Name of Plugging Contractor Ace Pipe Pulling Co.  
Address Box 304 Great Bend, Ks.

STATE OF Kansas COUNTY OF Russell, ss.  
John O. Farmer (employee of owner) or (owner or operator) of the above-described well, being first duly sworn on oath, says: That I have knowledge of the facts, statements, and matters herein contained and the log of the above-described well as filed and that the same are true and correct. So help me God.  
(Signature) John O. Farmer


SUBSCRIBED AND SWORN TO before me this 30th day of January, 1962  
(Address) Dorothy Gatta  
My commission expires 5/18/64 Notary Public.

STATE OF KANSAS  
STATE CORPORATION COMMISSION

WELL PLUGGING RECORD

Give All Information Completely  
Make Required Affidavit  
Mail or Deliver Report to:  
Conservation Division  
State Corporation Commission  
211 No. Broadway  
Wichita, Kansas

Saline County. Sec. 2 Twp. 16 Rge. 4 (E) 1 (W)  
Location as "NE/CNW/SW" or footage from lines SE NE SE  
Lease Owner John O. Farmer Inc.  
Lease Name Sandberg Well No. 3  
Office Address 370 W. Wichita Russell, Ks.  
Character of Well (completed as Oil, Gas or Dry Hole) Oil  
Date well completed June 20, 1962  
Application for plugging filed Dec. 1, 1961  
Application for plugging approved Jan. 8, 1962  
Plugging commenced Jan. 8, 1962  
Plugging completed Jan. 25, 1962  
Reason for abandonment of well or producing formation  
No longer a producer  
If a producing well is abandoned, date of last production 19  
Was permission obtained from the Conservation Division or its agents before plugging was commenced?

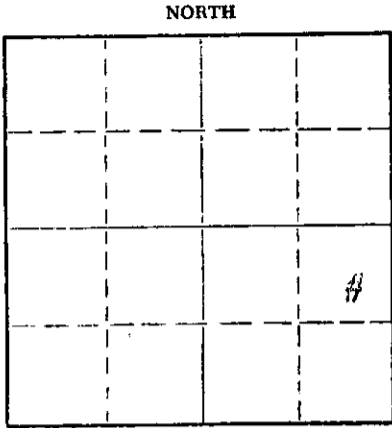

Locate well correctly on above Section Plat

Name of Conservation Agent who supervised plugging of this well  
Producing formation Depth to top Bottom Total Depth of Well Feet  
Show depth and thickness of all water, oil and gas formations.

OIL, GAS OR WATER RECORDS

CASING RECORD

FORMATION	CONTENT	FROM	TO	SIZE	PUT IN	PULLED OUT
				8 5/8	340'	none
				5 1/2	3435'	2852'

Describe in detail the manner in which the well was plugged, indicating where the mud fluid was placed and the method or methods used in introducing it into the hole. If cement or other plugs were used, state the character of same and depth placed, from feet to feet for each plug set.

Plugged back with sand from 3442' to 3425'. Mixed and dumped 5 sq. cement from 3425' to 3385'. Pulled casing. Mudded to 160'. Set 10' rock bridge from 160' to 150'. Dumped 2 yds. ready mix cement from 150' to base collar.

RECEIVED  
STATE CORPORATION COMMISSION

JAN 31 1962

CONSERVATION DIVISION  
Wichita, Kansas

(If additional description is necessary, use BACK of this sheet)

Name of Plugging Contractor Ace Pipe Pulling Co.  
Address Box 304 Great Bend, Ks.

STATE OF Kansas COUNTY OF Russell, ss.  
John O. Farmer (employee of owner) or (owner or operator) of the above-described well, being first duly sworn on oath, says: That I have knowledge of the facts, statements, and matters herein contained and the log of the above-described well as filed and that the same are true and correct. So help me God.  
(Signature) John O. Farmer

SUBSCRIBED AND SWORN TO before me this 30th day of January, 1962

My commission expires 5/18/64  
Dorothy Ratto Notary Public.

well log

15169-00951-0000

Jones, Shelburne & Farmer  
Sandberg #3

SE NE SE  
Section 2-165-4W  
Saline County, Kansas

T. D. 3442'  
Commenced: March 23, 1952  
Completed: April 6, 1952  
Drilled by: Shields Drilling Co., Inc.

CASING RECORD

8 5/8" 337' Cemented w/  
300 sax.  
8 1/2" 3439' Cemented w/  
100 sax

Elevation: 1323  
Treatment:  
Production: 149 bbls x 2 3/4 wts

----- Figures Indicate Bottom of Formation -----

Top Soil & Sand	25	Lime, Shale & Salt	1101
SLate & Sand	65	Shale & Shells	1210
Shale & Shells	287	Shale & Salt	1290
Jin & Anhydrite	339	Shale, Shells & Salt	1460
W. O. C.		Lime & Shale	1525
Anhydrite	418	Shale	1660
Broken Anhydrite	475	Shale & Lime	2845
Lime & Shale	620	Shale	2914
Red Bed & Shale	660	Lime & Shale	3185
Lime, Shale & Shells	765	Shale	3265
Lime & Shale	840	Shale	3415
Shale & Shells	880	Shale & Lime	3440
Lime & Shale	1000	Lime	3442 T. D.
Sale & Shale	1060		

TOPS

Anhydrite 337'  
Maquoketa Del. 3438'

Tops - Seamt  
Miss 2922  
Kinderhook 3225  
Maquoketa Sh. 3375  
Maquoketa Dds 3434

NOTES

Rotary Total Depth 3442'  
D. S. T. #1 3438-40' Rec. 5' Mud  
D. S. T. #2 3440-42' Rec. 5' Mud BHP 4604.

RECEIVED  
STATE CORPORATION COMMISSION  
JAN 11 1962  
CONSERVATION DIVISION  
WICHITA, Kansas