

STATE OF KANSAS
STATE CORPORATION COMMISSION

Give All Information Completely
Make Required Affidavit
Mail & Deliver Report to:
Conservation Division
State Corporation Commission
211 No. Broadway
Wichita, Kansas

15-169-00956-0000


WELL PLUGGING RECORD

No Log

Saline County, Sec. 2 Twp. 16 Rge. 4 (E) W (W)

Location as "NE/CNW/SW" or footage from lines SW NE SE
Lease Owner John O. Farmer Inc.
Lease Name Sandberg Well No. 2
Office Address 370 W. Wichita Russell, Ka.
Character of Well (completed as Oil, Gas or Dry Hole) Oil
Date well completed Feb. 8, 1952
Application for plugging filed Dec. 1, 1961
Application for plugging approved Jan. 2, 1962
Plugging commenced Jan. 2, 1962
Plugging completed Jan. 27, 1962
Reason for abandonment of well or producing formation No longer a producer.
If a producing well is abandoned, date of last production 19
Was permission obtained from the Conservation Division or its agents before plugging was commenced? Yes

NORTH

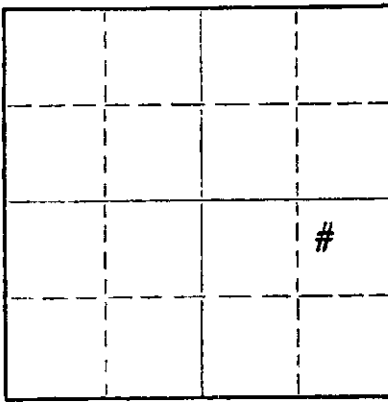

Locate well correctly on above Section Plat

Name of Conservation Agent who supervised plugging of this well Cecil Jones
Producing formation _____ Depth to top _____ Bottom _____ Total Depth of Well _____ Feet
Show depth and thickness of all water, oil and gas formations.

OIL, GAS OR WATER RECORDS

CASING RECORD

FORMATION	CONTENT	FROM	TO	SIZE	PUT IN	PULLED OUT
				8 5/8	335'	none
				5 1/2	3441'	2587'

Describe in detail the manner in which the well was plugged, indicating where the mud fluid was placed and the method or methods used in introducing it into the hole. If cement or other plugs were used, state the character of same and depth placed, from _____ feet to _____ feet for each plug set.

Plugged back with sand from 3444' to 3430'. Mixed and dumped 5 sq. cement from 3430' to 3390'. Pulled casing. Mudded hole to 160'. Set 10' rock bridge from 160' to 150'. Dumped 2 yds. ready mix cement from 150' to base cellar.

RECEIVED
STATE CORPORATION COMMISSION

JAN 31 1962

CONSERVATION DIVISION
Wichita, Kansas

(If additional description is necessary, use BACK of this sheet)

Name of Plugging Contractor Ace Pipe Pulling Co.
Address Box 304 Great Bend, Ka.

STATE OF Kansas COUNTY OF Russell SS.
John O. Farmer (employee of owner) or (owner or operator) of the above-described well, being first duly sworn on oath, says: That I have knowledge of the facts, statements, and matters herein contained and the log of the above-described well as filed and that the same are true and correct. So help me God.
(Signature) John O. Farmer

SUBSCRIBED AND SWORN TO before me this 30th day of January, 1962
Stanley Gatto (Address)
My commission expires 5/18/64 Notary Public.

WELL LOG BUREAU—KANSAS GEOLOGICAL SOCIETY
503 East Murdock, Wichita, Kansas

COPY


15-169-00956-0000

Company- JONES, SHELBURNE & FARMER, INC.
Farm- Sanberg No. 2

SEC. 2 T. 16 R. 4W
SW NE SE.

Total Depth. 3443
Comm. 11-20-51 Comp. 12-3-51
Shot or Treated.
Contractor. Honaker Drlg. Co., Inc.
Issued. 12-20-52

County Saline
KANSAS

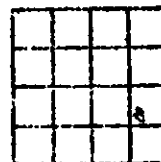

Elevation. 1328

Production. 34 BO & 84% wtr.

CASING:

13 3/8" 72' cem. w/150 sx
8 5/8" 335' cem. w/250 sx
5 1/2" 3441' cem. w/100 sx

Figures indicate Bottom of Formations.

top soil & sand	20
shale & sand	60
shale	72
shale & red bed	100
shale & sand	130
shale & gyp	280
anhydrite	335
anhydrite brkn	420
lime & shale	1070
lime, shale & salt	1323
lime & shale	1850
lime	2175
shale	2270
lime & shale	2470
lime	2542
shale & lime	2635
lime	2720
lime & shale	2935
lime	3238
shale	3443
Total Depth	

Scout Tops:	
Miss.	2924
Kinderhook	3231
Maquoketa Shale	3380
Dolomite	3441

RECEIVED
STATE CORPORATION COMMISSION
SEP 28 1962
CONSERVATION DIVISION
Wichita, Kansas