


Give All Information Completely
Make Required Affidavit
Mail or Deliver Report to:
Conservation Division
State Corporation Commission
211 No. Broadway
Wichita, Kansas

WELL PLUGGING RECORD

NORTH

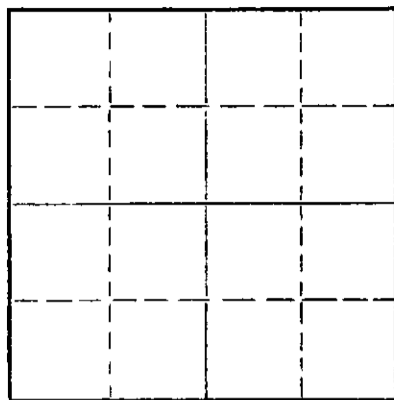

Locate well correctly on above
Section Plat

Saline County. Sec. 17 Twp. 16 Rge. 1 (E) (W)
Location as "NE/CNW%SW%" or footage from lines NE SW SW
Lease Owner Chas. E. Petrey
Lease Name Carber Well No. 1
Office Address 1300 N. Maple, McPherson, Kansas
Character of Well (completed as Oil, Gas or Dry Hole) Oil
Date well completed 10-15-60 19
Application for plugging filed 10-12-60 19
Application for plugging approved 10-12-60 19
Plugging commenced 10-13-60 19
Plugging completed 10-15-60 19
Reason for abandonment of well or producing formation dry

If a producing well is abandoned, date of last production 19
Was permission obtained from the Conservation Division or its agents before plugging was commenced?

Name of Conservation Agent who supervised plugging of this well Gilbert Toman
Producing formation _____ Depth to top _____ Bottom _____ Total Depth of Well 2707 Feet
Show depth and thickness of all water, oil and gas formations.

OIL, GAS OR WATER RECORDS

CASING RECORD

FORMATION	CONTENT	FROM	TO	SIZE	PUT IN	PULLED OUT

Describe in detail the manner in which the well was plugged, indicating where the mud fluid was placed and the method or methods used in introducing it into the hole. If cement or other plugs were used, state the character of same and depth placed, from _____ feet to _____ feet for each plug set.

Sand to 2690' mixed and dumped 5 sacks cement.
Mud to 160' set 10' rock bridge with 15 sack cement.
Mud to 25' set rock bridge with 5 sacks cement.

RECEIVED
STATE CORPORATION COMMISSION

OCT 19 1960

CONSERVATION DIVISION
WICHITA, KANSAS

(If additional description is necessary, use BACK of this sheet)

Name of Plugging Contractor Southwest Casing Pulling Co., Inc.
Address Box 364, Great Bend, Kansas

STATE OF Kansas, COUNTY OF Barton, ss.
Southwest Casing Pulling Co., Inc. (employee of owner) or (owner or operator) of the above-described well, being first duly sworn on oath, says: That I have knowledge of the facts, statements, and matters herein contained and the log of the above-described well as filed and that the same are true and correct. So help me God.

(Signature) Warren D. Harner
Box 364, Great Bend, Kansas
(Address)

SUBSCRIBED AND SWORN TO before me this 18 day of October, 19 60

My commission expires 24 October 1960
Sidney D. Miller
Notary Public.



17-96-1W

Rebent 3 south 15-16-17 00886-0000
2 west of gyp

Company: *Power Paper* Burr Miller
 Contractor: *Chas Petrey* Mallard Drilling Company
 Well: Karber #1
 Location: 850' from N. Line 330' from S. Line
 Commenced: Dec. 17-16-17 Saline County, Kansas
 Completed: July 21, 1958 S W $\frac{1}{4}$
 July 27, 1958

0	to	75	Sand and shale
75	to	164	Shale
164	to	530	Line
530	to	720	Line
720	to	1100	Shale and lime
1100	to	1415	Shale
1415	to	1645	Shale and lime
1645	to	1915	Lime
1915	to	2072	Shale and lime
2072	to	2210	Line
2210	to	2320	Line
2320	to	2697	Shale and lime
2697	to	2707	Mississippi
		2707	T. D. Rotary

RECEIVED
 STATE CORPORATION COMMISSION
 OCT 21 1960
 CONSERVATION DIVISION
 Wichita, Kansas

Set 164 ft. 8 5/8" surface pipe. Cemented with 100 sacks cement.
 Set 5 1/2" at 2704. Cemented with 40 sacks cement.

ROPS: Br. Line-- 2012 K.C. -- 2072 Chat -- 2697

Measurements taken from R.D.R. P.D.R. 5 1/2' from ground level.

C E R T I F I C A T E

I, C. C. Nelson, do hereby certify that the above and foregoing is a true and correct copy of log of the Karber #1, Saline County, Kansas, as reflected by files of the Mallard Drilling Company.

C. C. Nelson

Subscribed and sworn to before me a Notary Public, within and for Sedgwick County, Kansas, this 6th day of August 1958.

Edward V. Sage

My commission expires March 12, 1962