


WELL PLUGGING RECORD

Give All Information Completely
Make Required Affidavit
Mail or Deliver Report to:
Conservation Division
State Corporation Commission
800 Bitting Building
Wichita, Kansas

NORTH

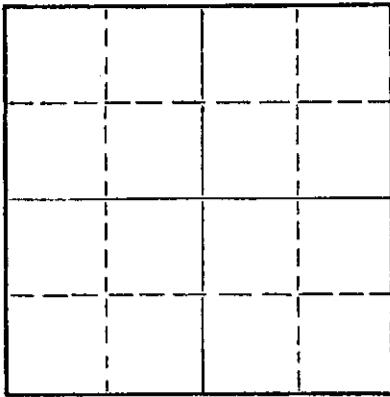

Locate well correctly on above
Section Plat

Saline County. Sec. 17 Twp. 16 Rge. (E) 1 (W)
Location as "NE/CNW/SW" or footage from lines SE SE SW
Lease Owner Musgrove Petroleum Corporation
Lease Name KARBIE Well No. 1
Office Address 518 Petroleum Building, Wichita, Kans.
Character of Well (completed as Oil, Gas or Dry Hole) Dry hole
Date well completed July 20 19 54
Application for plugging filed August 10, 19 54
Application for plugging approved August 10, 19 54
Plugging commenced August 23, 1954 19 54
Plugging completed August 23, 19 54
Reason for abandonment of well or producing formation Dry

If a producing well is abandoned, date of last production 19
Was permission obtained from the Conservation Division or its agents before plugging was commenced? Yes

Name of Conservation Agent who supervised plugging of this well Ruel Durkee, Box 597, McPherson, Ks.
Producing formation _____ Depth to top _____ Bottom _____ Total Depth of Well 2690 1/2 Feet
Show depth and thickness of all water, oil and gas formations.

OIL, GAS OR WATER RECORDS

CASING RECORD

FORMATION	CONTENT	FROM	TO	SIZE	PUT IN	PULLED OUT
				8-5/8"	123'	
				5-1/2"	268 1/2'	1450'

Describe in detail the manner in which the well was plugged, indicating where the mud fluid was placed and the method or methods used in introducing it into the hole. If cement or other plugs were used, state the character of same and depth placed, from _____ feet to _____ feet for each plug set.

Filled hole from 1990 to 1880 with sand & 6 sx cement.
Filled to 1835 and pulled pipe. Filled to 130' -
set 10' rock bridge with 20 sx cement. Filled
hole with mud to 20'. Set 5' rock bridge at 15'
with 5 sacks cement. Filled to top.

(If additional description is necessary, use BACK of this sheet)

Name of Plugging Contractor Jayhawk Casing & Pulling Co.,
Address Russell, Kansas.

STATE OF Kansas COUNTY OF Sedgwick
I, Gordon L. Koelling (employee of owner) or (owner or operator) of the above-described well, being first duly sworn on oath, says: That I have knowledge of the facts, statements, and matters herein contained and the log of the above-described well as filed and that the same are true and correct. So help me God.

(Signature) Gordon L. Koelling
518 Petroleum Building, Wichita, Kansas
(Address)

SUBSCRIBED AND SWORN to before me this 25th day of August, 19 54

My commission expires July 16, 1955.

Anna E. Rosen
Notary Public.

PLUGGING
FILE SEC 12 T 16 R 11
BOOK PAGE 55 LINE 2

RECEIVED
STATE CORPORATION COMMISSION
AUG 27 1954
CONSERVATION DIVISION
Wichita, Kansas

00663
15-169-00663-0000

CONTRACTOR'S WELL LOG

COMPANY:	Musgrove Petroleum Corporation
CONTRACTOR:	Musgrove Petroleum Corporation
FARM:	KARBER #1
LOCATION:	SE SE SW, Sec. 17-16-1 Saline County, Kansas.
COMMENCED:	July 12, 1954
COMPLETED:	July 20, 1954

0	10	Surface soil
10	123	Sand & shale
123	200	Shale & shells
200	350	Sandy lime & pyrite streaks
350	515	Shale & Fort Riley Lime
515	820	Lime & shale
820	1100	Shale & lime streaks
1100	1870	Shale & lime
1870	1890	Coring
1890	2690 $\frac{1}{2}$	Lime & shale
	2690 $\frac{1}{2}$	Rotary Total Depth

Set 8-5/8" surface at 123' with 125 sacks cement

Set 5 $\frac{1}{2}$ " pipe at 2684 $\frac{1}{2}$ ' with 225 sacks cement

STATE OF KANSAS)
) SS
COUNTY OF SEDGWICK)

I, GORDON L. KOELLING, do hereby certify that the above and foregoing is a true and correct copy of the log of the KARBER #1, SE SE SW, Section 17-16-1, Saline County, Kansas, as reflected by the files of the Musgrove Petroleum Corporation.

MUSGROVE PETROLEUM CORPORATION

BY Gordon L. Koelling
Secretary-Treasurer

Subscribed and sworn to before me, a Notary Public, in and for Sedgwick County, Kansas, this 26th day of July, 1954.

Alma E. Ross
Notary Public

My commission expires July 16, 1955

RECORDED
STATE COUNTY OF SEDGWICK
AUG 11 1954
CONSERVATION DIVISION
Wichita, Kansas

PLUGGING
FILE SEC 17-16-1W
BOOK PAGE 55 LINE 9