

STATE OF KANSAS
STATE CORPORATION COMMISSION


Form CP-4

Give All Information Completely
Make Required Payment
Mail or Deliver Report to:
Conservation Division
State Corporation Commission
212 No. Market
Wichita, Kansas 67202

WELL PLUGGING RECORD

Harper County, Sec. 7 Twp. 33 Rge. (E) 5 (W)

Location as "NE/CNW/SW" or footage from lines CE SW NE
Lease Owner Aladdin Petroleum Corporation
Lease Name Schwamborn Well No. 1
Office Address 809 Petroleum Building, Wichita, Kansas
Character of Well (completed as Oil, Gas or Dry Hole) oil
Date well completed _____ 19____
Application for plugging filed _____ 19____
Application for plugging approved _____ 19____
Plugging commenced May 6 1971
Plugging completed May 11 1971
Reason for abandonment of well or producing formation depleted

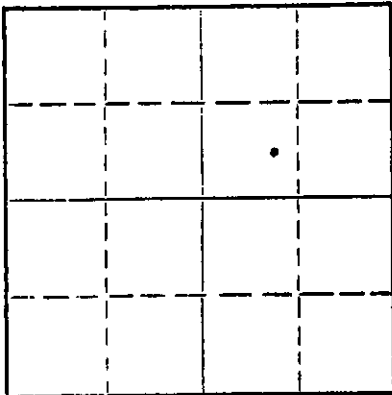

Locate well correctly on above Section Plat

If a producing well is abandoned, date of last production _____ 19____
Was permission obtained from the Conservation Division or its agents before plugging was commenced? yes

Name of Conservation Agent who supervised plugging of this well G. R. Biberstein
Producing formation _____ Depth to top _____ Bottom _____ Total Depth of Well 5143 Feet
Show depth and thickness of all water, oil and gas formations.

OIL, GAS OR WATER RECORDS

CASING RECORD

FORMATION	CONTENT	FROM	TO	SIZE	PUT IN	PULLED OUT
		0	248'	8 5/8"	248'	none
		0	5010'	5 1/2"	5010'	4531.01

Describe in detail the manner in which the well was plugged, indicating where the mud fluid was placed and the method or methods used in introducing it into the hole. If cement or other plugs were used, state the character of same and depth placed, from _____ feet to _____ feet for each plug set.

Sanded back to 4800' and dumped 5 sacks of cement.
Set 20' rock bridge at 240'.
Plugged well with 4 yards of ready mix cement.

RECEIVED
STATE CORPORATION COMMISSION
MAY 27 1971
CONSERVATION DIVISION
Wichita, Kansas

(if additional description is necessary, use BACK of this sheet)
Name of Plugging Contractor PIPE PULLERS, INC.
Address Box 486, Ellinwood, Kansas

STATE OF KANSAS, COUNTY OF BARTON, ss.
Evelyn Roth (employee of owner) or (owner-or operator) of the above-described well, being first duly sworn on oath, says: That I have knowledge of the facts, statements, and matters herein contained and the log of the above-described well as filed and that the same are true and correct. So help me God.

(Signature) Evelyn Roth
Ellinwood, Kansas (Address)

SUBSCRIBED AND SWORN to before me this 25th day of May, 1971

My commission expires Feb. 10, 1975

George A. Meyer
Notary Public.

RECEIVED
STATE CORPORATION COMMISSION
MAY 4 1971
CONSERVATION DIVISION
Wichita, Kansas

WELL LOG - # 1

15-077-00002-00-01

Schwaborn #1

OPERATOR: Aladdin Petroleum Corporation
809 Petroleum Building
Wichita, Kansas 67202

LOCATION: C-SW-NE
Sec. 7-33-5
Harper County,
Kansas

CONTRACTOR: German Drilling Company
502 Petroleum Building
Wichita, Kansas 67202

Farm: Roth
Date Commenced: 11-25-65
Date Completed: 11-28-65

Well No. 1

<u>From</u>	<u>To</u>	<u>Formation</u>
0	5143	Wash Down
70	2282	Washing Down
2282	3019	Washing Down
3019	3780	Washing Down
3780	4980	Washing Down
4980	5070	Wash Old Hole
5070	5105	Arbuckle Lime
5105	5143	Arbuckle
5143	T.D.	

I hereby certify that the foregoing is a true and correct copy of the Well log for the Roth # 1, drilled for Aladdin Petroleum Corporation and completed November 28, 1965.


GERMAN DRILLING COMPANY

Production Pipe-5079 ft.- 5 1/2"


Harvey F. German-Owner

STATE OF KANSAS)
) ss.
COUNTY OF SEDGWICK)

Subscribed and sworn to, before the undersigned, a Notary Public, in and for County and State aforesaid, this thirtieth day of November, 1965.


Geneva M. German- Notary Public

My Commission expires February 28, 1968