


Give All Information Completely
Make Required Affidavit
Mail & Deliver Report to:
Conservation Division
State Corporation Commission
212 No. Market
Wichita, Kansas

WELL PLUGGING RECORD

15-101-20298-0000

NORTH

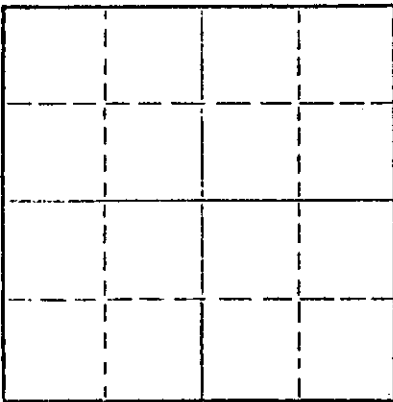

Locate well correctly on above
Section Plat

Lane _____ County. Sec. 23 Twp. 19 Rge. 29W (E) _____ (W) _____
Location as "NE/CNW/SW" or footage from lines SW NW SW
Lease Owner Donald C. Slawson
Lease Name Hansen 'F' Well No. 1
Office Address 200 Douglas Building, Wichita, Kansas 67202
Character of Well (completed as Oil, Gas or Dry Hole) dry hole
Date well completed March 13 1978
Application for plugging filed March 13 1978
Application for plugging approved March 13 1978
Plugging commenced March 13 1978
Plugging completed March 13 1978
Reason for abandonment of well or producing formation dry hole

If a producing well is abandoned, date of last production _____ 19____
Was permission obtained from the Conservation Division or its agents before plugging was commenced? yes

Name of Conservation Agent who supervised plugging of this well Gilbert Balthazor
Producing formation _____ Depth to top _____ Bottom _____ Total Depth of Well 4730 Feet
Show depth and thickness of all water, oil and gas formations.

OIL, GAS OR WATER RECORDS

CASING RECORD

FORMATION	CONTENT	FROM	TO	SIZE	PUT IN	PULLED OUT
	251.20	surface	258	8 5/8"		

Describe in detail the manner in which the well was plugged, indicating where the mud fluid was placed and the method or methods used in introducing it into the hole. If cement or other plugs were used, state the character of same and depth placed, from _____ feet to _____ feet for each plug set.

1st plug @ 800' 70 sx
2nd plug @ 240' w/20 sx
3rd plug @ 40' w/10 sx
2 sx in rat hole

RECEIVED
STATE CORPORATION COMMISSION
APR 21 1978
CONSERVATION DIVISION
Wichita, Kansas

(If additional description is necessary, use BACK of this sheet)
Name of Plugging Contractor Slawson Drilling Co., Inc.
Address 200 Douglas Building, Wichita, Kansas 67202

STATE OF Kansas, COUNTY OF Sedgwick, ss.
R. J. Thatcher (employee of owner) or (owner or operator) of the above-described well, being first duly sworn on oath, says: That I have knowledge of the facts, statements, and matters herein contained and the log of the above-described well as filed and that the same are true and correct. So help me God.

(Signature) R. J. Thatcher

(Address)

SUBSCRIBED AND SWORN to before me this 19th day of April, 1978

My commission expires 11/9/80

Margene Hamer
Notary Public.



WELL LOG

15-101-20298-0000

OPERATOR: Donald C. Slawson
200 Douglas Building
Wichita, Kansas 67202

LEASE: #1 Hansen 'F'
SW NW SW Sec. 23-19-29W
Lane County, Kansas

CONTRACTOR: Slawson Drilling Company, Inc.
200 Douglas Building
Wichita, Kansas 67202

COMMENCED: March 3, 1978

COMPLETED: March 13, 1978

CASING: Surface - 8 5/8" @ 258' w/200 sx 60/40 poz

0 - 262	Surface hole
262 - 1256	Shale and shells
1256 - 1665	Sand
1665 - 2155	Shale and shells
2155 - 2182	Anhydrite
2182 - 2630	Shale
2630 - 3820	Lime and shale
3820 - 3950	Lime
3950 - 4204	Lime and shale
4204 - 4305	Lime
4305 - 4375	Lime and shale
4375 - 4730	Lime
4730	RTD


RECEIVED
STATE CORPORATION COMMISSION
APR 21 1978
CONSERVATION DIVISION
Wichita, Kansas

STATE OF KANSAS)
) SS.
COUNTY OF SEDGWICK)

I, R.J. Thatcher, of the Slawson Drilling Company, Inc., upon oath state that the above and foregoing is a true and correct copy of the log of the #1 Hansen 'F' test.


R.J. Thatcher

Subscribed and sworn to before me this 19th day of April, 1978.

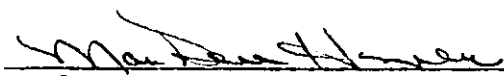
MarGene Hamer, Notary Public

