

NOTICE OF INTENTION TO DRILL

(see rules on reverse side)

Starting Date 7 10 86 month day year

API Number 15- 101-21,322-0000

OPERATOR: License # 5886
Name Chief Drilling Co., Inc.
Address 151 N. Main #700
City/State/Zip Wichita, Ks. 67202
Contact Person Douglas W. Thimesch
Phone 316-262-3791

NE SE SW Sec. 36 Twp. 19 S, Rg. 29 East
990 X West
2970 Ft. from South Line of Section
Ft. from East Line of Section

(Note: Locate well on Section Plat on reverse side)

CONTRACTOR: License # 5883
Name Warrior Drilling Co. Rig #2
City/State Wichita, Kansas 67202

Nearest lease or unit boundary line 330 feet
County Lane

Lease Name Truan Well # 2

Ground surface elevation will provide feet MSL

Domestic well within 330 feet: yes no

Municipal well within one mile: yes no

Depth to bottom of fresh water 150

Depth to bottom of usable water 1000

Surface pipe by Alternate: 1 2 X

Surface pipe planned to be set 300

Conductor pipe required

Projected Total Depth 4700 feet

Formation Mississippi

Well Drilled For: Well Class: Type Equipment:
X Oil SWD Infield X Mud Rotary
Gas Inj X Pool Ext Air Rotary
OWWO Expl Wildcat Cable

If OWWO: old well info as follows:

Operator

Well Name

Comp Date Old Total Depth

I certify that well will comply with K.S.A. 55-101, et seq., plus eventually plugging hole to KCC specifications.

Date 6-26-86 Signature of Operator or Agent Douglas W. Thimesch Title Vice President

For KCC Use:

Conductor Pipe Required feet; Minimum Surface Pipe Required 250 feet per Alt. 9(2)


This Authorization Expires 12-30-86 Approved By 6-30-86

Handwritten signature and initials at bottom right.

Must be filed with the K.C.C. five (5) days prior to commencing well
 This card void if drilling not started within six (6) months of date received by K.C.C.

Important procedures to follow:

A Regular Section of Land
 1 Mile = 5,280 Ft.

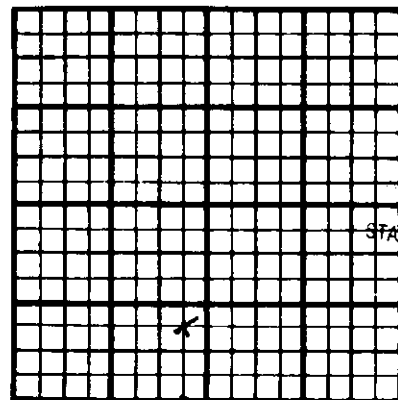

RECEIVED
 STATE CORPORATION COMMISSION

6-30-86 JUN 30 1986

CONSERVATION DIVISION
 Wichita, Kansas

RECEIVED
 STATE CORPORATION COMMISSION

JUN 27 1986

CONSERVATION DIVISION
 Wichita, Kansas

1. Notify District office before setting surface casing.
2. Set surface casing by circulating cement to the top.
3. File completion forms ACO-1 with K.C.C. within 90 days of well completion, following instructions on ACO-1, side 1, and including copies of wireline logs.
4. Notify District office 48 hours prior to old well workover or re-entry.
5. Prior to filing Intent, prepare a proposed plugging plan in case well is D & A, then obtain approval of plan when calling district office prior to setting surface pipe.
6. Submit plugging report (CP-4) to K.C.C. after plugging is completed.
7. Obtain an approved injection docket number before disposing of salt water.
8. Notify K.C.C. within 10 days when injection commences or terminates.
9. If an alternate 2 completion, cement in the production pipe from below any usable water to surface within 120 days of spud date.

State Corporation Commission of Kansas
 Conservation Division
 200 Colorado Derby Building
 Wichita, Kansas 67202
 (316) 263-3238