

NOTICE OF INTENTION TO DRILL

(see rules on reverse side)

Expected Spud Date... 5... 12... 88... month day year

API Number 15-101-21,472-0000

OPERATOR: License # 5886
Name Chief Drilling Co., Inc.
Address 151 N. Main #700
City/State/Zip Wichita, KS 67202
Contact Person Douglas W. Thimesch
Phone 316-262-3791

SE NW NW Sec. 26 Twp. 19 S, Rg. 29 East
4290 Ft. from South Line of Section
4290 Ft. from East Line of Section

(Note: Locate well on Section Plat on reverse side)

CONTRACTOR: License # 5883
Name Warrior Drilling Co.
City/State Wichita, KS

Nearest lease or unit boundary line 990 feet
County Lane

Lease Name Jewett Well # 1
Ground surface elevation Will provide feet MSL

Well Drilled For: Well Class: Type Equipment:
X Oil Storage Infield X Mud Rotary
Gas Inj Pool Ext Air Rotary
OWWO Expl X Wildcat Cable

Domestic well within 330 feet: yes X no
Municipal well within one mile: yes X no

Depth to bottom of fresh water 100

Depth to bottom of usable water 1200

Surface pipe by Alternate: 1 2 X

If OWWO: old well info as follows:

Surface pipe planned to be set 290

Operator
Well Name
Comp Date Old Total Depth

Conductor pipe required none

Projected Total Depth 4700 feet

Formation Mississippi

I certify that well will comply with K.S.A. 55-101, et seq., plus eventually plugging hole to KCC specifications.

Date 5-4-88 Signature of Operator or Agent Douglas W. Thimesch Title Vice President

For KCC Use:

Conductor Pipe Required feet; Minimum Surface Pipe Required 200 feet per Alt. X 2

This Authorization Expires 11-5-88 Approved By RCH 5-5-88


EFFECTIVE DATE: 5-10-88

Must be filed with the K.C.C. five (5) days prior to commencing well
This card void if drilling not started within six (6) months of date received by K.C.C.

Important procedures to follow:

1. Notify District office before setting surface casing.
2. Set surface casing by circulating cement to the top.
3. File completion forms ACO-1 with K.C.C. within 120 days of well spud date, following instructions on ACO-1, side 1, and including copies of wireline logs.
4. Notify District office 48 hours prior to old well workover or re-entry.
5. Prior to filing Intent, prepare a proposed plugging plan in case well is D & A, then obtain approval of plan when calling district office prior to setting surface pipe.
6. Submit plugging report (CP-4) to K.C.C. after plugging is completed.
7. Obtain an approved injection docket number before disposing of salt water.
8. Notify K.C.C. within 10 days when injection commences or terminates.
9. If an alternate 2 completion, cement in the production pipe from below any usable water to surface within 120 days of spud date.

A Regular Section of Land 1 Mile = 5,280 Ft.

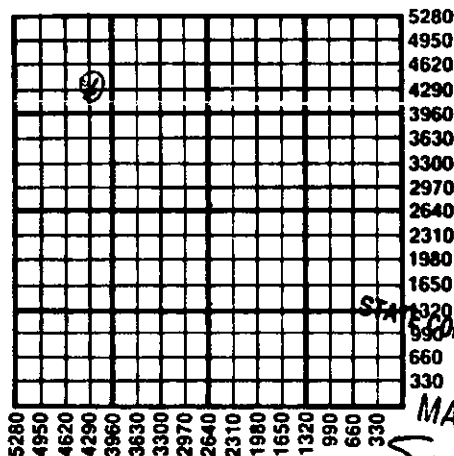

RECEIVED
STATE CORPORATION COMMISSION

MAY 05 1988
5-5-88
CONSERVATION DIVISION
Wichita, Kansas

State Corporation Commission of Kansas
Conservation Division
200 Colorado Derby Building
Wichita, Kansas 67202-1212
(316) 263-3238